IREDELL COUNTY HEALTH DEPARTMENT

STATESVILLE 704-878-5305 MOORESVILLE 704-664-5281

IMPROVEMENT PERMIT / AUTHORIZATION TO CONSTRUCT / OPERATION PERMIT / EXISTING SYSTEM INSPECTION

550.00 Paid 10:30

PERMIT# 133460 PIN# 4627 89 6461.000 DATE 2/1/06

OWNER OR APPLICANT Gordon + Cheryl Barkley PHONE: Business Home 704-664-9237

ADDRESS 111 Mainview Dr. Mooresville NC. 28117

LOCATION 138 Red Brook Ln. I 150 W TL Paradise Pen. TL Red Bud to cul de sac on (R)

SUBDIVISION Pinnacle Shores BLOCK / SECTION 4 LOT 7 LOT AREA 1.07AC SITE CLASS. PS DESIGN FLOW 360 L.T.A.R. .25

Septic Tank: 1000 Gallons; STB 312 Date 6-20-07

Pump Tank: 1000 Gallons; PT 283 Date 10-26-07

Pump Make Goulds Model PE5IM Serial No.

Nitrification Field: No Fields ___ Square Feet 1920 Linear Feet 240

No Lines 6 @ 40 Trench Width 2' Max Trench Bottom Depth 3'

☒ New System ☐ Repair ☐ Expansion System Type: I II III (IV) V VI

System Description: PRESDOSED - 16" PP3BPS

Repair System Description: SAME

Maintenance Agreement Required: ☒ Yes ☐ No

☒ House/Mod. Home ☐ Mobile Home ☐ Business ☐ Other

No. Bedrooms 3 No. Persons ___ No. Employees ___


Water Supply: ☐ Individual ☐ Public ☒ Community

Gravel Depth NA ☐ Gravity ☒ Pressure ☐ Slab ☐ Crawl Space ☒ Basement w/plumbing ☐ Basement wo/plumbing


Comments/Conditions: 56 PANELS - 34 GPM @ ELEVATION DETERMINED ON SITE BY CONTRACTOR - CALL ICHD WITH QUESTIONS.

Comments/Conditions: 11/30/07 Checked tanks, lines & pressure Lines = 80, 70 & 90

INITIAL SITE SKETCH

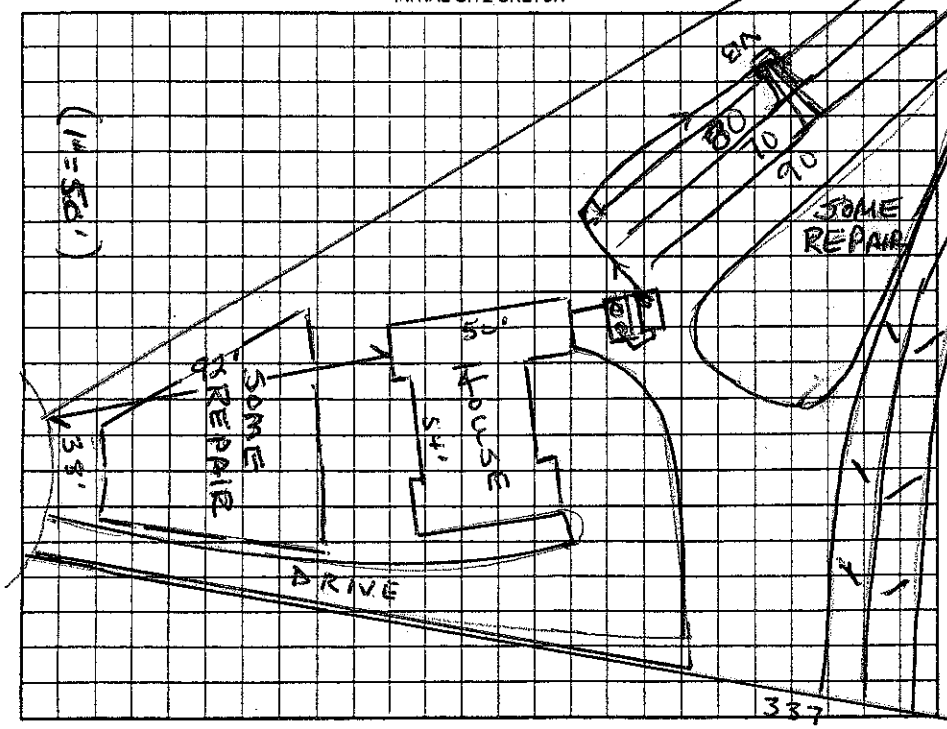

AS BUILT SKETCH

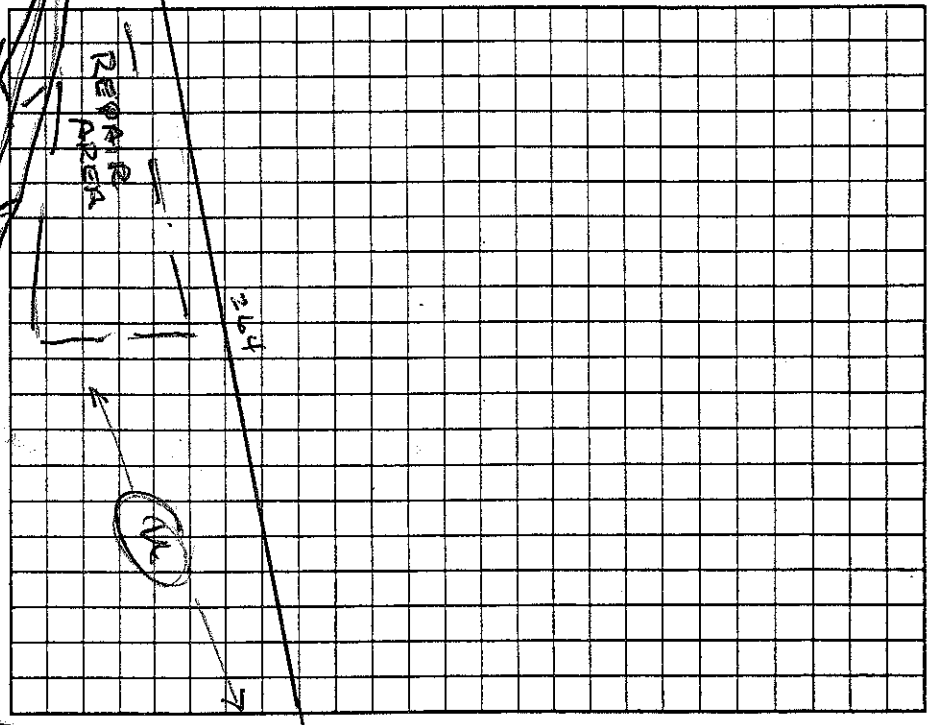

Permit can be suspended or revoked if any false information is supplied toward securing the permit/any unauthorized changes are made to the site/any unauthorized changes are made in the installation of the system. Improvement Permit with plat valid without expiration ☐ Improvement Permit with site plan valid for sixty months ☐ Authorization to Construct is valid for a period equal to that of Improvement Permit – not to exceed sixty months.

Signed: * Gordon J Barkley date 2/14/06

Improvement Permit by: Wesley Sparks RS. date 2/1/06

Authorization to Construct by: Wesley Sparks RS date 2/1/06

Installed by: Richard Abernathy

Operation Permit by: Miriam H Dotson date 11/17/09

Existing System Inspection by: ___ date ___

HEALTH DEPT. COPY: WHITE OWNER COPY (FINAL): YELLOW OWNER COPY (INITIAL): PINK