IREDELL COUNTY HEALTH DEPARTMENT

STATESVILLE 704-878-5305 50.00 Paid MOORESVILLE 704-664-5281

IMPROVEMENT PERMIT / AUTHORIZATION TO CONSTRUCT / OPERATION PERMIT / EXISTING SYSTEM INSPECTION

PERMIT# 094667 PIN# ~~462781 4708~~ 4627900457 DATE 6/14/02

OWNER OR CONTRACTOR E.S. Johnson Builders PHONE: Business 704-896-8813 Home

ADDRESS PO Box 1402 Cornelius NC 28031

LOCATION Brawley Sch TR Blume, TL Booten Rd, TL Cicero, TL Shavenders, TR Bath Crk, on Lt.

SUBDIVISION Shavenders Bluff BLOCK / SECTION LOT 106 LOT AREA 0.88 AC. SITE CLASS PS DESIGN FLOW 440 L.T.A.R. 0.5

Septic Tank: 1000 Gallons; STB Date 3/11/02

Pump Tank: Gallons; PT Date

Pump Make: Model Serial No.

Nitrification Field: No Fields 1 Square Feet 1200 Linear Feet 400

No Lines 5@80' Trench Width 36" Max Trench Bottom Depth 36" Gravel Depth —

☒ New System ☐ Repair System Type: I, II, (III), IV, V, VI

System Description: Gravity 25% Reduction

Repair System Description: Same

Maintenance Agreement Required: ☐ Yes ☒ No

☒ House/Mod. Home No. Bedrooms 4

☐ Mobile Home No. Bathrooms 3

☐ Business No. Employees

☐ Other

☐ Slab ☒ Crawl Space ☐ Basement w/plumbing ☐ Basement wo/plumbing


Water Supply: ☒ Individual ☐ Public ☐ Community

Comments:/Conditions:


well

Comments:/Conditions:

INITIAL SITE SKETCH

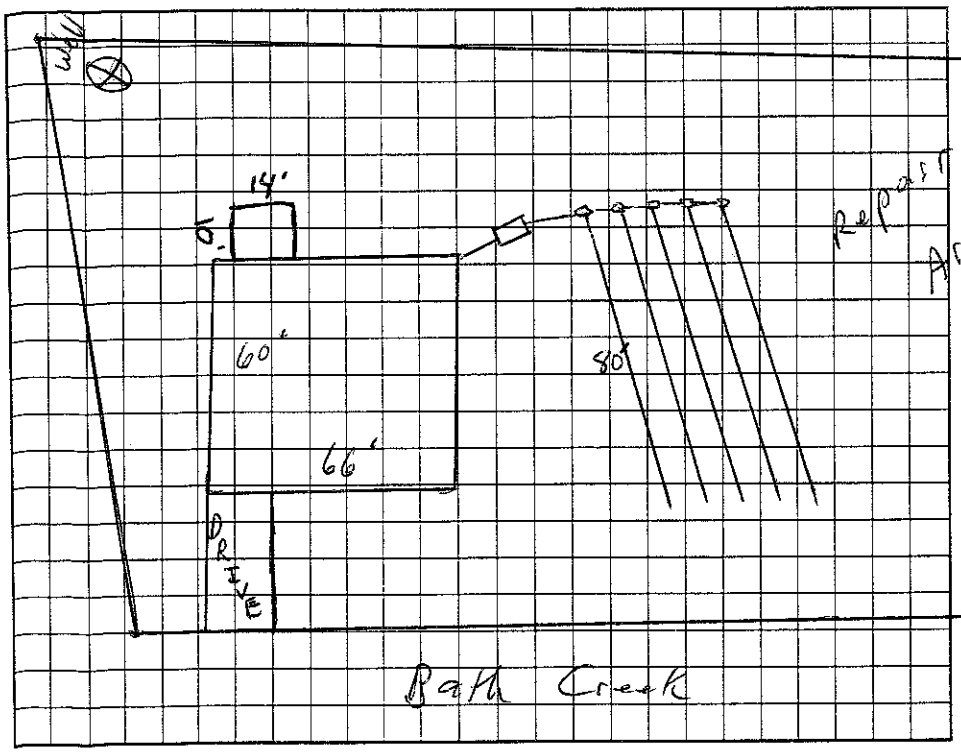

AS BUILT SKETCH

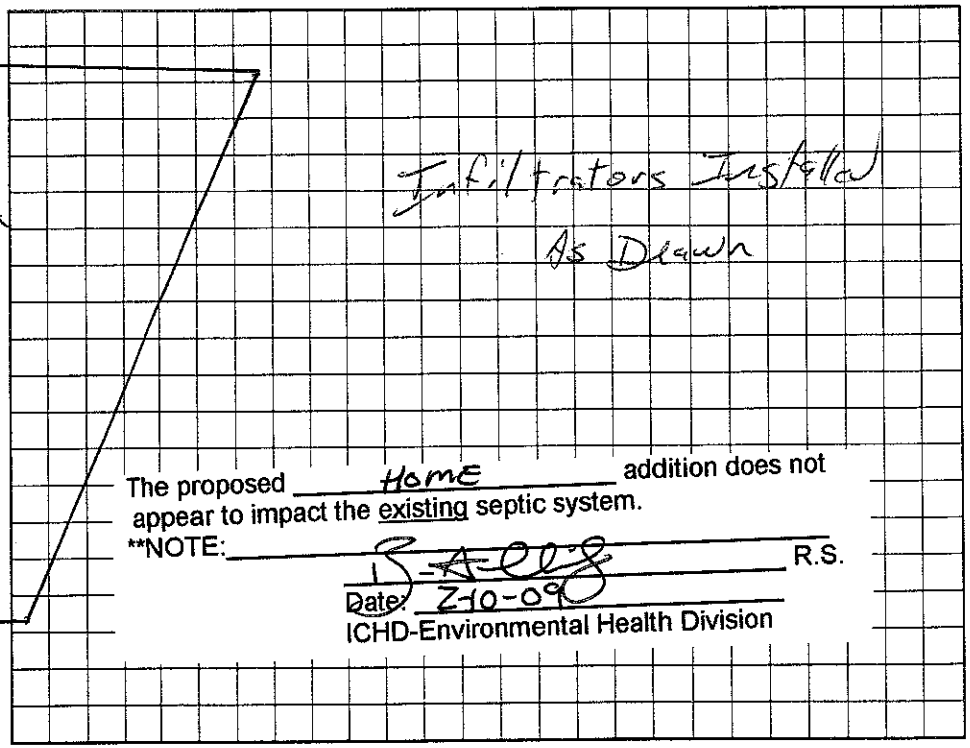

The proposed Home addition does not appear to impact the existing septic system.

**NOTE:

R.S.

Date: 2-10-09

ICHD-Environmental Health Division

Permit can be suspended or revoked if any false information is supplied toward securing the permit/any unauthorized changes are made to the site/any unauthorized changes are made in the installation of the system. Improvement Permit with plan valid without expiration. Improvement Permit with site plan valid for sixty months. Authorization to Construct is valid for a period equal to that of Improvement Permit – not to exceed sixty months.

Signed: date 6/20/02 Installed by: Tommy Frye

Improvement Permit by: RS date 6/14/02 Operation Permit by: RS date 11/20/02

Authorization to Construct by: RS date 6/14/02 Existing System Inspection by: date

HEALTH DEPT. COPY: WHITE OWNER COPY (FINAL): YELLOW OWNER COPY (INITIAL): PINK