Beaten Path

IREDELL COUNTY HEALTH DEPARTMENT

STATESVILLE 704-878-5305 MOORESVILLE 704-664-5281

IMPROVEMENT PERMIT / AUTHORIZATION TO CONSTRUCT / OPERATION PERMIT / EXISTING SYSTEM INSPECTION

PERMIT# 161299 PIN# 4627-90-1484 DATE 6-23-10

OWNER OR CONTRACTOR CHRIS BELLER PHONE: Business 704-661-5778 Home

ADDRESS 12214 RALEY RD CORNELIUS NC 28031

LOCATION 724 BEATEN PATH RD

SUBDIVISION ~~SHAVENDERS BLUFF~~ BLOCK / SECTION TRACT 2 LOT 1542 LOT AREA 1.75 Ac SITE CLASS. DESIGN FLOW 480GPD L.T.A.R. .3

Septic Tank: 1000 Gallons; STB 794 Date 11-28-14
Pump Tank: 1000 Gallons; PT 27 Date 2-4-15
Pump Make: Gould's Model WE0712HV Serial No.
Nitrification Field: No Fields 1 Square Feet 1200' Linear Feet 400'
No Lines 4 @ 100' Trench Width 36" Max Trench Bottom Depth 36" Gravel Depth

☒ New System ☐ Repair System Type: I II III IV V VI
System Description: PM 25% REDUCTION
Repair System Description: LP PANEL BLOCK
Maintenance Agreement Required: ☐ Yes ☒ No INITIALLY


☒ House/Mod. Home No. Bedrooms 4
☐ Mobile Home No. Bathrooms
☐ Business No. Employees
☐ Other
☐ Slab ☐ Crawl Space ☒ Basement w/plumbing ☐ Basement wo/plumbing

Water Supply: ☒ Individual ☐ Public ☐ Community


Comments/Conditions: 3/11/15 Checked tanks, lines & set pressure

Comments/Conditions: Used Quick 4

INITIAL SITE SKETCH

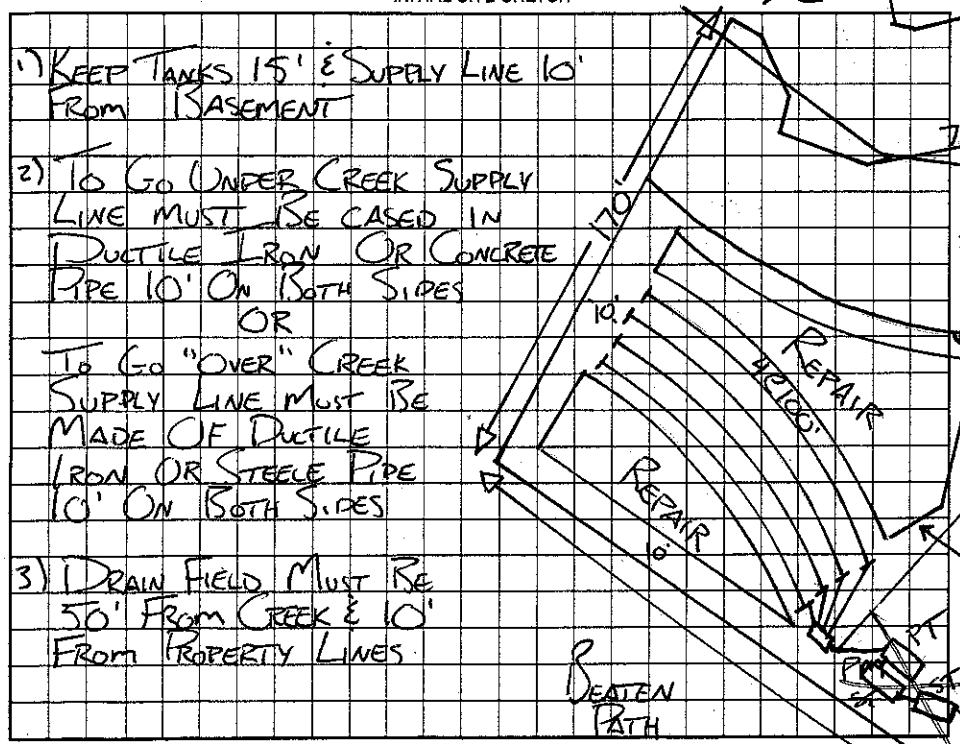

AS BUILT SKETCH

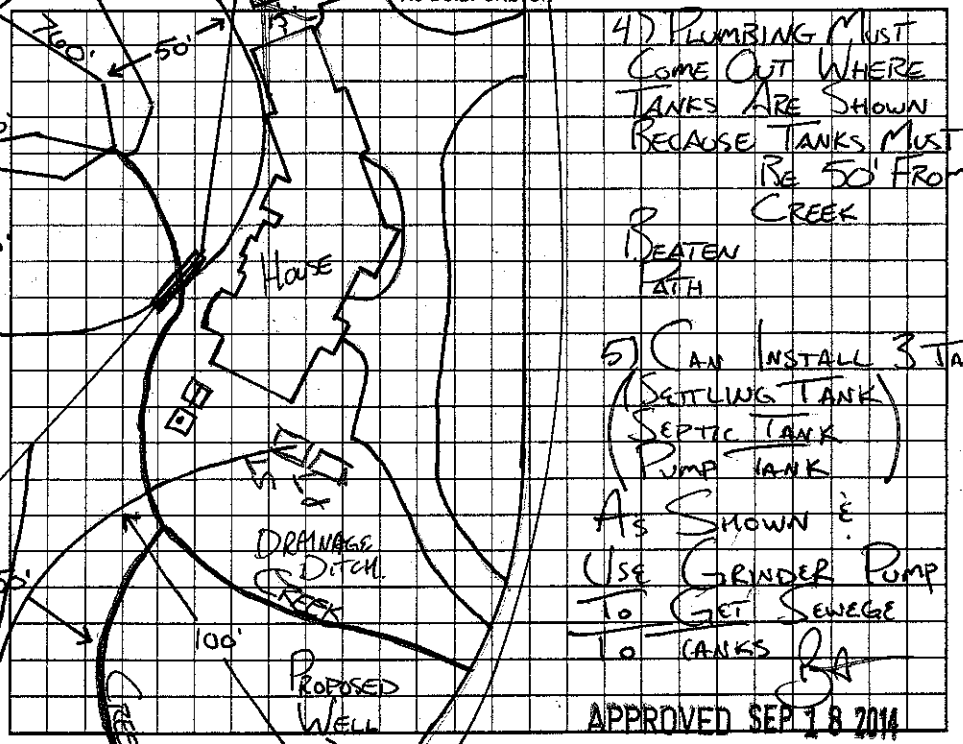

Permit can be suspended or revoked if any false information is supplied toward securing the permit/any unauthorized changes are made to the site/any unauthorized changes are made in the installation of the system. Improvement Permit with plat valid without expiration. Improvement Permit with site plan valid for sixty months. Authorization to Construct is valid for a period equal to that of Improvement Permit not to exceed sixty months.

Signed: date 8/7/12

Improvement Permit by: R-A-C-Reps date 6-25-10

Authorization to Construct by: Cindy McBride date 8-7-12

Installed by: EJ Ervin's

Operation Permit by: Norman Dotson BS date 3/11/15

Existing System Inspection by: date

HEALTH DEPT. COPY: WHITE OWNER COPY (FINAL): YELLOW OWNER COPY (INITIAL): PINK