IREDELL COUNTY HEALTH DEPARTMENT

STATESVILLE 704-878-5305 MOORESVILLE 704-664-5281

IMPROVEMENT PERMIT / AUTHORIZATION TO CONSTRUCT / OPERATION PERMIT / EXISTING SYSTEM INSPECTION

PERMIT# 94665 PIN# ~~4627854 9105~~ PT 4627904953 DATE 6/12/01

OWNER OR CONTRACTOR SHAVENDERS DEV. GROUP (Richard Brown) PHONE: Business 919-469-4738 Home

ADDRESS 1143-D EXECUTIVE CIRCLE CARY NC 27511 (Lee Cty.)

LOCATION

SUBDIVISION SHAVENDERS BLUFF BLOCK / SECTION 20 LOT 104 LOT AREA .186AC SITE CLASS. PS DESIGN FLOW 450GPD L.T.A.R. .36-PD/ET 2

Septic Tank: 1000 Gallons; STB 794 Date 2/22/02

Pump Tank: Gallons; PT Date

Pump Make: Model Serial No.

Nitrification Field: No Fields 1 Square Feet 1200 Linear Feet 400

No Lines 4@100' Trench Width 36" Max Trench Bottom Depth 36" Gravel Depth N/A

☑ New System ☐ Repair System Type: I, II, III, IV, V, VI

System Description: GRAVITY 25% REDUCTION

Repair System Description: UP PANEL

Maintenance Agreement Required: ☐ Yes ☑ No

☑ House/Mod. Home No. Bedrooms 4

☐ Mobile Home No. Bathrooms 4

☐ Business No. Employees

☐ Other

Water Supply: ☑ Individual ☐ Public ☐ Community


☐ Slab ☑ Crawl Space ☐ Basement w/plumbing ☐ Basement wo/plumbing

Comments:/Conditions:


Comments:/Conditions:

E-Z LAY INSTALLER

INITIAL SITE SKETCH 1"=50'

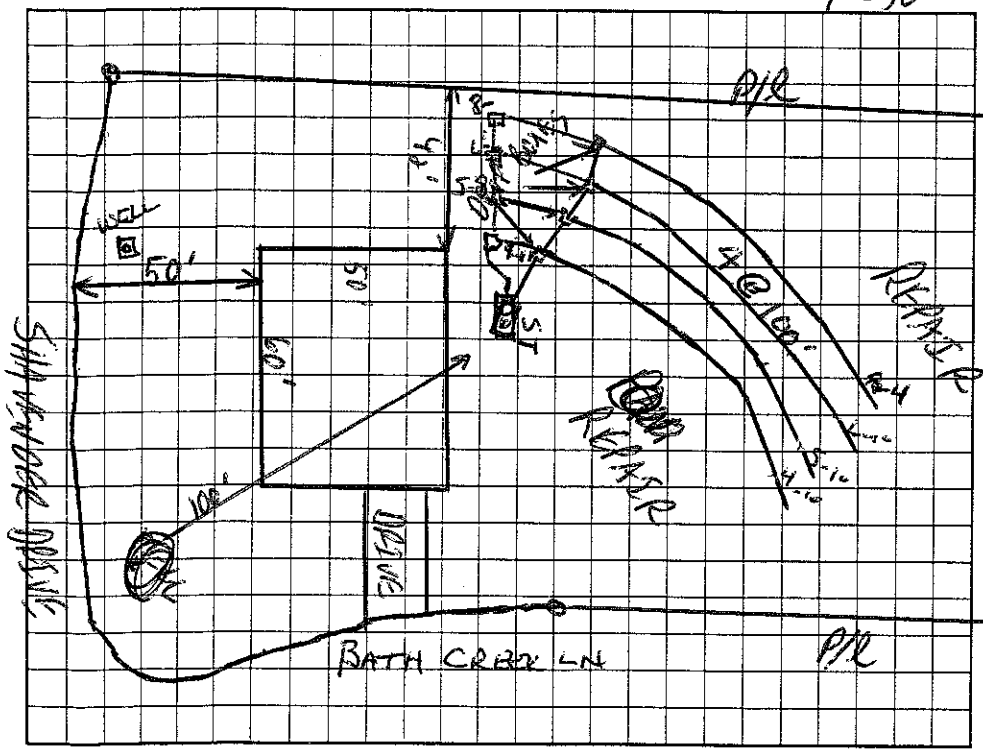

AS BUILT SKETCH

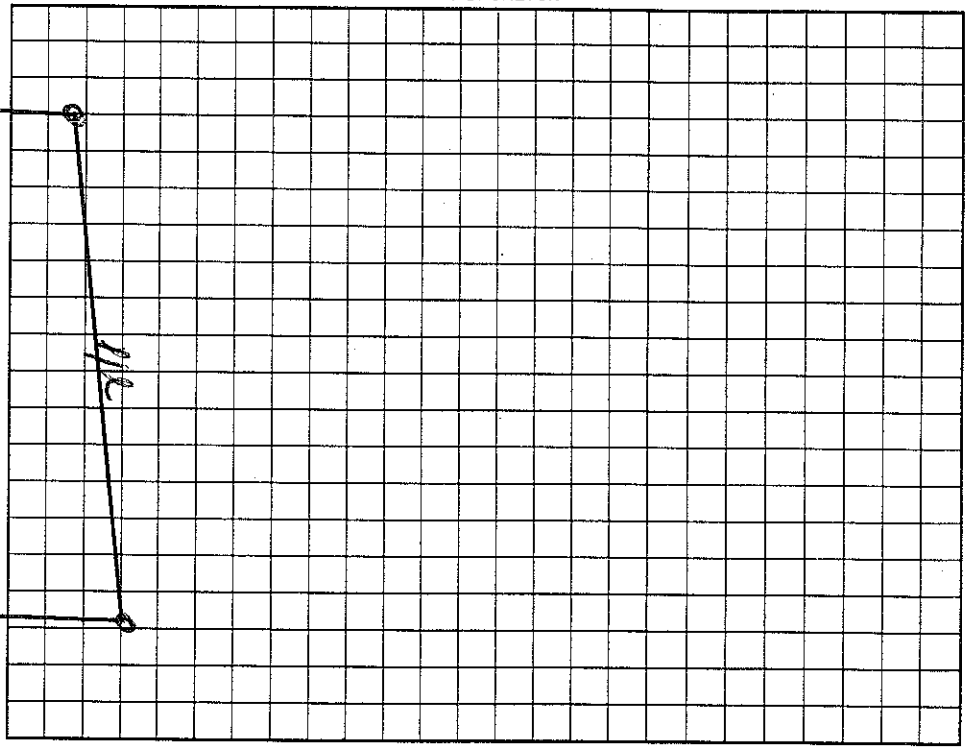

Permit can be suspended or revoked if any false information is supplied toward securing the permit/any unauthorized changes are made to the site/any unauthorized changes are made in the installation of the system. Improvement Permit with plat valid without expiration. Improvement Permit with site plan valid for sixty months. Authorization to Construct is valid for a period equal to that of Improvement Permit – not to exceed sixty months.

Signed: date 7-26-01 Installed by: Mike Kidd

Improvement Permit by: date 6/12/01 Operation Permit by: Wesley Sparks RS. date 8/2/02

Authorization to Construct by: Wesley Sparks RS. date 1/14/02 Existing System Inspection by: date

HEALTH DEPT. COPY: WHITE OWNER COPY (FINAL): YELLOW OWNER COPY (INITIAL): PINK