IREDELL COUNTY HEALTH DEPARTMENT

STATESVILLE 704-878-5305 375.00 Paid 3.00 MOORESVILLE 704-664-5281

IMPROVEMENT PERMIT / AUTHORIZATION TO CONSTRUCT / OPERATION PERMIT / EXISTING SYSTEM INSPECTION

PERMIT# 107428 PIN# 4627-90-7412.334 4627-90-7479 DATE Aug 22,02

OWNER OR CONTRACTOR Shevenda Dev Group Top Notch Homes Inc PHONE: Business Home

ADDRESS 1143-B Executive Dr. Cary N.C. 27511

LOCATION Brawley School Rd. TR Blume TL Beaten Path TL Cicero TL Shevenda TL Palmer Marsh TL Archbell 1st on left

SUBDIVISION Shevenda Bluff BLOCK / SECTION 3 LOT 334 LOT AREA .699 ac SITE CLASS. 15 DESIGN FLOW 360gpd L.T.A.R. .2-.3

Septic Tank: 1000 Gallons; STB 794 Date 7/1/03
Pump Tank: 1000 Gallons; PT 27 Date 7/1/03
Pump Make: Gould's Model WE03 1/M Serial No M02562S1
Nitrification Field: No Fields 1 Square Feet 520/780 Linear Feet 260
No Lines 4 Trench Width 24" MIN Bac Max Trench Bottom Depth 36" Gravel Depth NA

☑ New System ☐ Repair System Type: I. II. III. ☑ V. VI
System Description: LPPPBPS
Repair System Description: SAME
Maintenance Agreement Required: ☑ Yes ☐ No

☑ House/Mod. Home No. Bedrooms 3
☐ Mobile Home No. Bathrooms 3
☐ Business No. Employees
☐ Other


☐ Slab ☑ Crawl Space ☐ Basement w/plumbing ☐ Basement wo/plumbing

Water Supply: ☐ Individual ☐ Public ☐ Community

Comments:/Conditions: 36" MAX 9" oc
Barely sufficient space for 3 Bedroom LP Panel Block
No upgrade!

Comments:/Conditions: Reviewed building & site plans & they are in compliance with Septic permit.

INITIAL SITE SKETCH

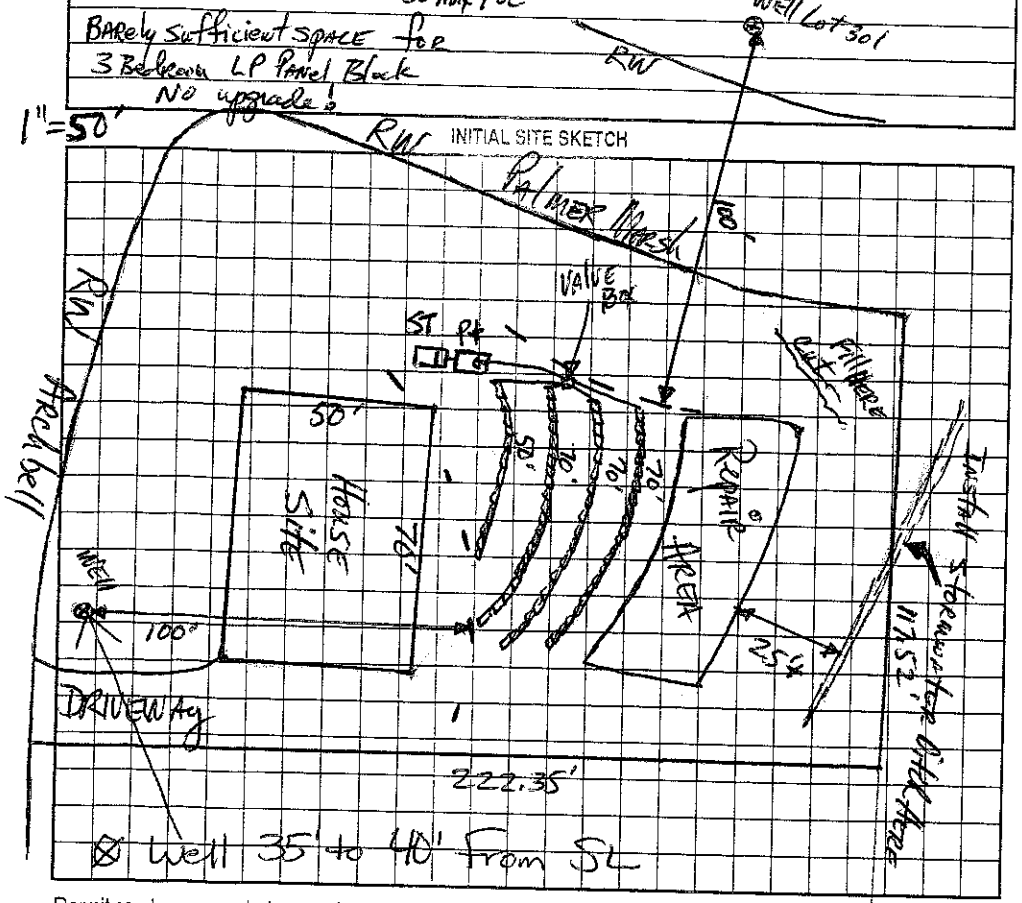

AS BUILT SKETCH

60 Panels 5/32" holes

Permit can be suspended or revoked if any false information is supplied toward securing the permit/any unauthorized changes are made to the site/any unauthorized changes are made in the installation of the system. Improvement Permit with plat valid without expiration. Improvement Permit with site plan valid for sixty months. Authorization to Construct is valid for a period equal to that of Improvement Permit – not to exceed sixty months.

Signed:

Improvement Permit by: date 8-29-02

Authorization to Construct by: date 8-22-02

date 12/18/02

Installed by: Marty Tucker

Operation Permit by: RS date 9/5/03

Existing System Inspection by: date

HEALTH DEPT. COPY: WHITE OWNER COPY (FINAL): YELLOW OWNER COPY (INITIAL): PINK