IREDELL COUNTY HEALTH DEPARTMENT

STATESVILLE 704-878-5305 50.00 Paid 3:30 MOORESVILLE 704-664-5281

IMPROVEMENT PERMIT / AUTHORIZATION TO CONSTRUCT / OPERATION PERMIT / EXISTING SYSTEM INSPECTION

PERMIT# 91276 PIN# ~~4627814014 PT~~ 4627907962 DATE 5/14/01

OWNER OR CONTRACTOR SHAVENDER DEVELOPMENT GROUP / KEVIN HAFESTETTER PHONE: Business 799-0328 Home

ADDRESS 1143-D EXECUTIVE DR.

LOCATION BRAWLEY SCHOOL - TR BLUME - TL BEATEN PATH - TL CICERO - TL SHAVENDER ON LT

SUBDIVISION SHAVENDER'S BLUFF BLOCK / SECTION LOT 88 LOT AREA .183AC SITE CLASS. PS DESIGN FLOW 600GD L.T.A.R. 360 FT2

Septic Tank: 1500 Gallons; STB 338 Date 8-17-01

Pump Tank: 1500 Gallons; PT 338 Date 6-25-01

Pump Make: Gould's Model WE05111H Serial No.

Nitrification Field: No Fields 1 Square Feet 1500 Linear Feet 500

No Lines 4@125' Trench Width 36" Max Trench Bottom Depth 36" Gravel Depth N/A

☑ New System ☐ Repair System Type: I, II, (III), IV, V, VI

System Description: PUMP 25% REDUCTION

Repair System Description: LP PANEL

Maintenance Agreement Required: ☐ Yes ☑ No

☑ House/Mod. Home No. Bedrooms 5

☐ Mobile Home No. Bathrooms 5

☐ Business No. Employees

☐ Other


☐ Slab ☑ Crawl Space ☐ Basement w/plumbing ☐ Basement wo/plumbing

Water Supply: ☑ Individual ☐ Public ☐ Community


Comments:/Conditions:

Comments:/Conditions: Filter installed "Plastic Chambers" installed Tanks, lines & pressure Checked 9/21/2001

INITIAL SITE SKETCH

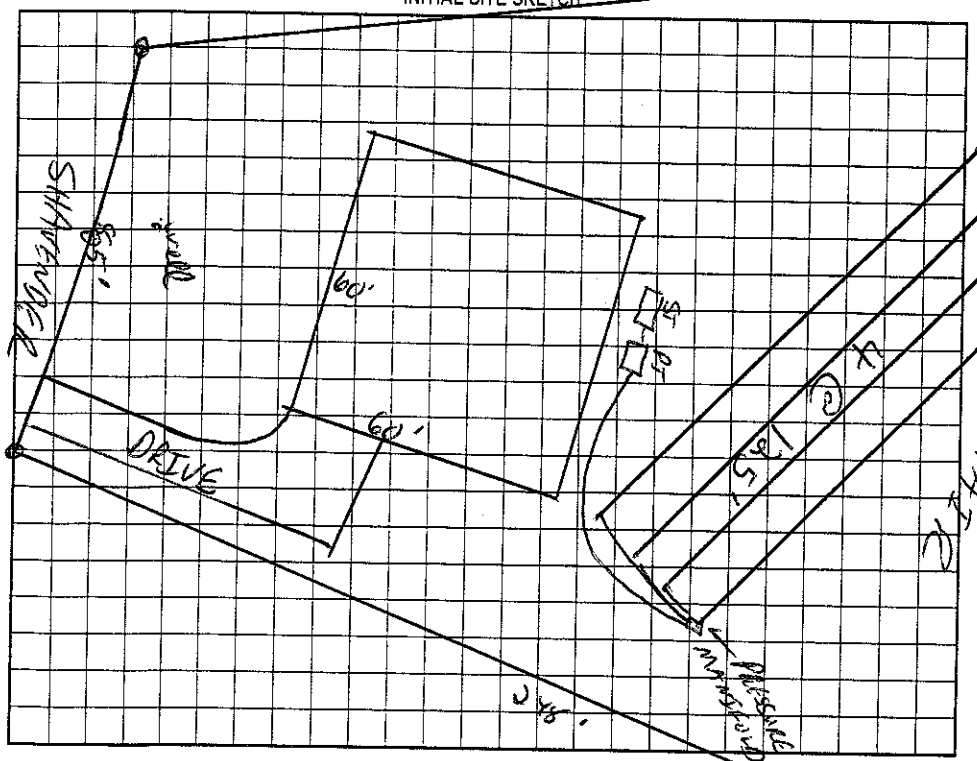

AS BUILT SKETCH

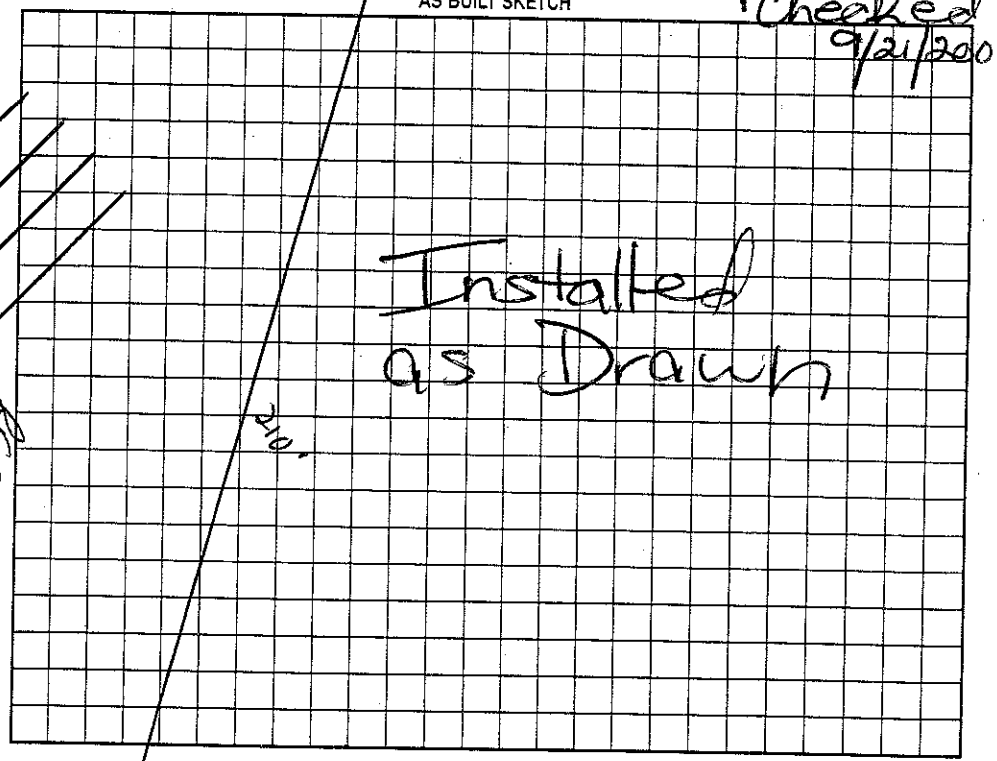

Permit can be suspended or revoked if any false information is supplied toward securing the permit/any unauthorized changes are made to the site/any unauthorized changes are made in the installation of the system. Improvement Permit with plat valid without expiration. Improvement Permit with site plan valid for sixty months. Authorization to Construct is valid for a period equal to that of Improvement Permit - not to exceed sixty months.

Signed: date 5/16/01

Improvement Permit by: date 5/14/01

Authorization to Construct by: date 5/14/01

Installed by: Atlantic Grading

Operation Permit by: Wesley Sparks RS. date 11/9/01

Existing System Inspection by: date

HEALTH DEPT. COPY: WHITE OWNER COPY (FINAL): YELLOW OWNER COPY (INITIAL): PINK