IREDELL COUNTY HEALTH DEPARTMENT

STATESVILLE 704-878-5305 125.00 Paid MOORESVILLE 704-664-5281

IMPROVEMENT PERMIT / AUTHORIZATION TO CONSTRUCT / OPERATION PERMIT / EXISTING SYSTEM INSPECTION

PERMIT# 094689 PIN# ~~4627-51-9108~~ PT 4627910079 DATE 9/20/01

OWNER OR CONTRACTOR SHAVENDER'S DEV. GROUP / JOHN DUPONT PHONE: Business 919 469 4738 Home

ADDRESS 1143 D EXECUTIVE CIRCLE CARY NC 27511

LOCATION BRAWLEY SCHOOL - TR BLUME - TL BEATEN PATH - TL SHAVENDERS - ON TR BATH RT [redacted]

SUBDIVISION SHAVENDER'S BLUFF BLOCK / SECTION LOT 122 LOT AREA .94AC SITE CLASS. PS DESIGN FLOW 360GPD L.T.A.R. .36 AD/KFT2

Septic Tank: 1000 Gallons: STB 1012 Date 4/16/02
Pump Tank: Gallons: PT Date
Pump Make: Model Serial No.
Nitrification Field: No Fields 1 Square Feet 400 Linear Feet 200
No Lines 5@40' Trench Width 24" Max Trench Bottom Depth 36" Gravel Depth N/A


☑ New System ☐ Repair System Type: I, II, III, IV, V, VI
System Description: GRAVITY PANEL
Repair System Description: SAME/LP
Maintenance Agreement Required: ☐ Yes ☑ No

☑ House/Mod. Home No. Bedrooms 3
☐ Mobile Home No. Bathrooms 3
☐ Business No. Employees
☐ Other
☐ Slab ☑ Crawl Space ☐ Basement w/plumbing ☐ Basement wo/plumbing

Water Supply: ☑ Individual ☐ Public ☑ Community

Comments:/Conditions:

INITIAL SITE SKETCH

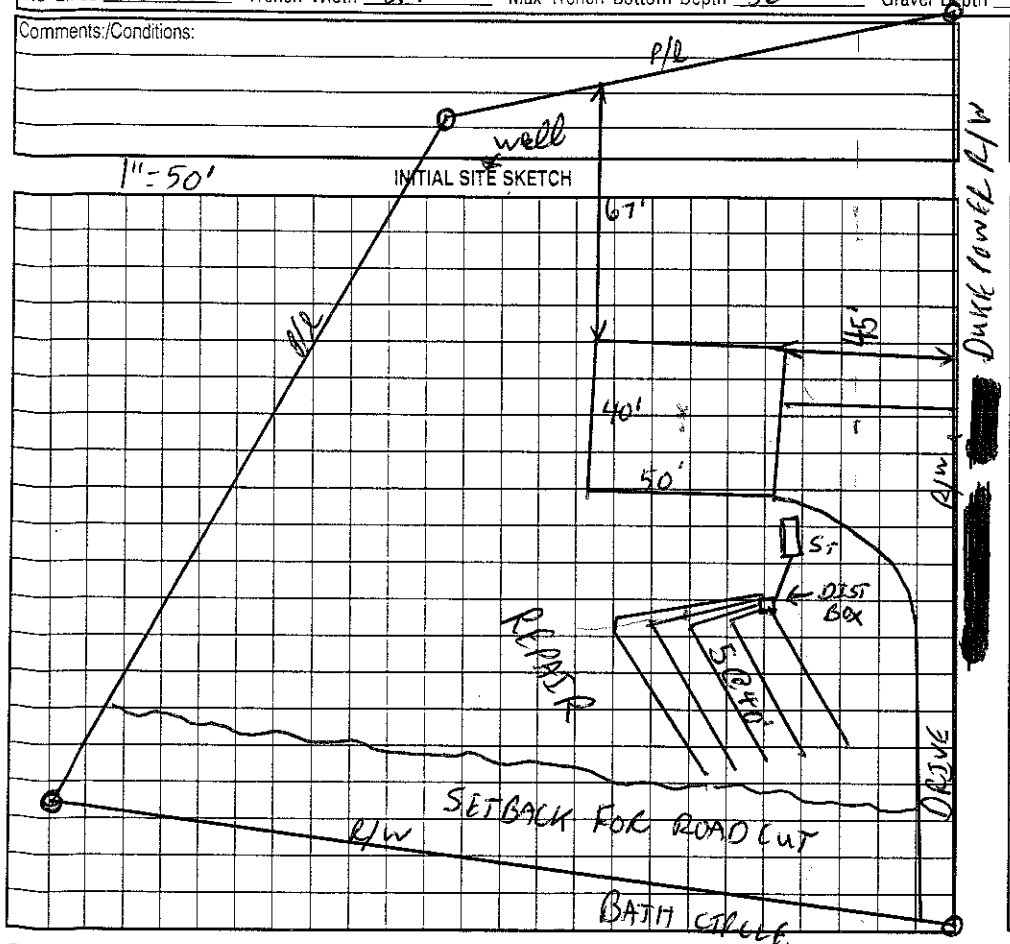

Comments:/Conditions:

AS BUILT SKETCH

Permit can be suspended or revoked if any false information is supplied toward securing the permit/any unauthorized changes are made to the site/any unauthorized changes are made in the installation of the system. Improvement Permit with plat valid without expiration. Improvement Permit with site plan valid for sixty months. Authorization to Construct is valid for a period equal to that of Improvement Permit – not to exceed sixty months.

Signed: [signature] date 10/4/01 Installed by: Abernathy

Improvement Permit by: C. Ray Teer RS date 9/20/01 Operation Permit by: Wesley Sparks RS. date 7/16/02

Authorization to Construct by: C. Ray Teer RS date 12/27/01 Existing System Inspection by: date

HEALTH DEPT. COPY: WHITE OWNER COPY (FINAL): YELLOW OWNER COPY (INITIAL): PINK