IREDELL COUNTY HEALTH DEPARTMENT

STATESVILLE 704-878-5305 MOORESVI 4-664-5281

IMPROVEMENT PERMIT / AUTHORIZATION TO CONSTRUCT / OPERATION PERMIT / EXISTING SYSTEM INSPECTION

>30 - 400

PERMIT# 88634 PIN# ~~4627 81 9014 Pt.~~ 4627912893 DATE 11/29/00

OWNER OR CONTRACTOR Allen Const. Co. PHONE: Business 261-3301 Home

ADDRESS PO Box 3174 Mooresville NC 28117

LOCATION Shoreview Bluff off Beaten Path N Cicero Ln., straight at cul de sac

SUBDIVISION Shore. Bluff. BLOCK / SECTION LOT 98 LOT AREA ? SITE CLASS. PS DESIGN FLOW 480 L.T.A.R. .3

Septic Tank: 1000 Gallons; STB 1012 Date 9-18-00
Pump Tank: Gallons; PT Date
Pump Make: Model Serial No.
Nitrification Field: No Fields 1 Square Feet 1200. Linear Feet 400
No Lines 5@80' Trench Width 3' Max Trench Bottom Depth 36" Gravel Depth 20"

[X] New System [ ] Repair System Type: I, II, III, IV, V, VI
System Description: 25% Reduced
Repair System Description: 16" PPBS
Maintenance Agreement Required: [ ] Yes [X] No


[X] House/Mod. Home No. Bedrooms 4
[ ] Mobile Home No. Bathrooms 4
[ ] Business No. Employees
[ ] Other
[ ] Slab [X] Crawl Space [ ] Basement w/plumbing [ ] Basement wo/plumbing

Water Supply: [X] Individual [ ] Public [ ] Community

Comments:/Conditions:

Comments:/Conditions: Infiltrators Installed

INITIAL SITE SKETCH

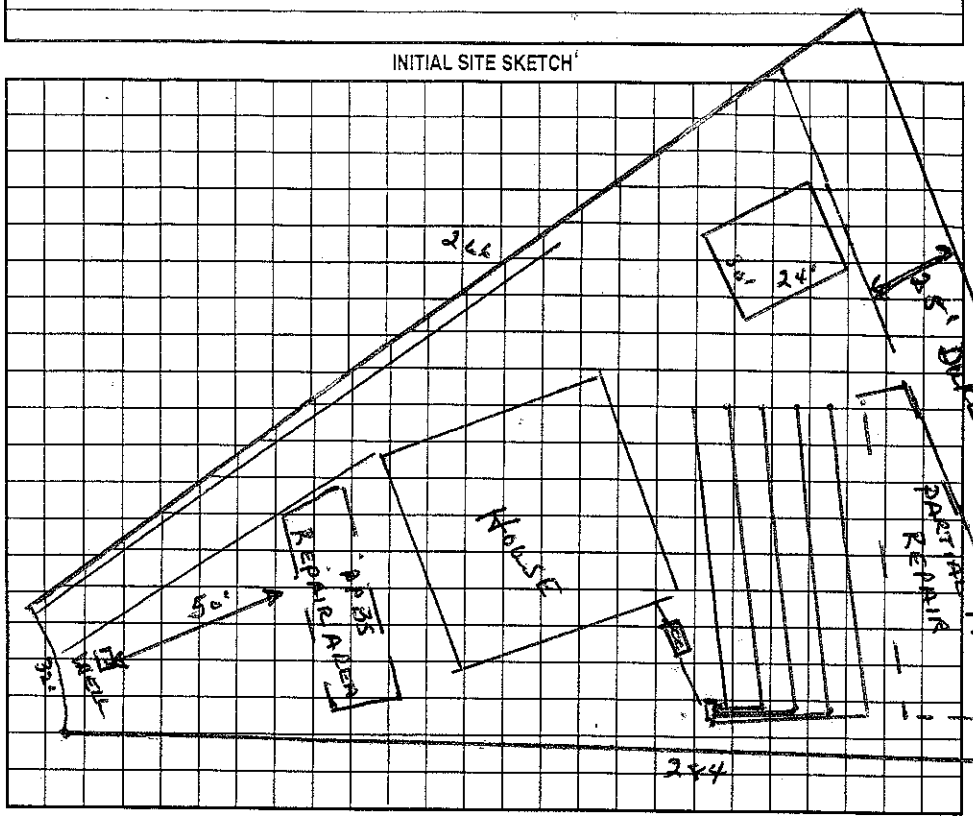

AS BUILT SKETCH

Permit can be suspended or revoked if any false information is supplied toward securing the permit/any unauthorized changes are made to the site/any unauthorized changes are made in the installation of the system. Improvement Permit with plat valid without expiration. Improvement Permit with site plan valid for sixty months. Authorization to Construct is valid for a period equal to that of Improvement Permit -- not to exceed sixty months.

Signed: X date

Improvement Permit by: Wesley Sparks RS date 11/29/00

Authorization to Construct by: Wesley Sparks RS date 11/29/00

Installed by: A-1 Backhoe

Operation Permit by: RSI date 1/25/01

Existing System Inspection by: date

HEALTH DEPT. COPY: WHITE OWNER COPY (FINAL): YELLOW OWNER COPY (INITIAL): PINK