C. Rg Zm 3/6/02

4.08

IREDELL COUNTY HEALTH DEPARTMENT

STATESVILLE 704-878-5305 MOORESVILLE 704-664-5281

IMPROVEMENT PERMIT / AUTHORIZATION TO CONSTRUCT / OPERATION PERMIT / EXISTING SYSTEM INSPECTION

PERMIT# 094663 94665 PIN# 4627 81 9108 PT 4627 91 4104 DATE 6/12/01

OWNER OR CONTRACTOR SHAVENDER'S DEV. GROUP PHONE: Business 919-469-7738 Home

ADDRESS 1143-D EXECUTIVE CIRCLE CARY NC 27511

LOCATION BRAWLEY SCHOOL - TR BLUME - TL BEAVER DAM - TL [redacted] CICERO - TL SHAVENDER - RIGHT

SUBDIVISION SHAVENDERS BLUFF BLOCK / SECTION 20 LOT 103 LOT AREA SITE CLASS. DESIGN FLOW L.T.A.R.

Septic Tank: 1000 Gallons; STB 1000 Date 4-4-02
Pump Tank: 1000 Gallons; PT 1000 Date 10-19-01
Pump Make: Model Serial No.
Nitrification Field: No Fields 1 Square Feet Linear Feet 270
No Lines 3@90' Trench Width 24" Max Trench Bottom Depth 36" Gravel Depth N/A


☑ New System ☐ Repair System Type: I, II, III, IV, V, VI
System Description: LP PANEL
Repair System Description: SAME
Maintenance Agreement Required: ☐ Yes ☑ No

☑ House/Mod. Home No. Bedrooms 4
☐ Mobile Home No. Bathrooms 4
☐ Business No. Employees
☐ Other
☐ Slab ☑ Crawl Space ☐ Basement w/plumbing ☐ Basement wo/plumbing

Water Supply: ☑ Individual ☐ Public ☐ Community


Comments:/Conditions:
1" = 50'

INITIAL SITE SKETCH

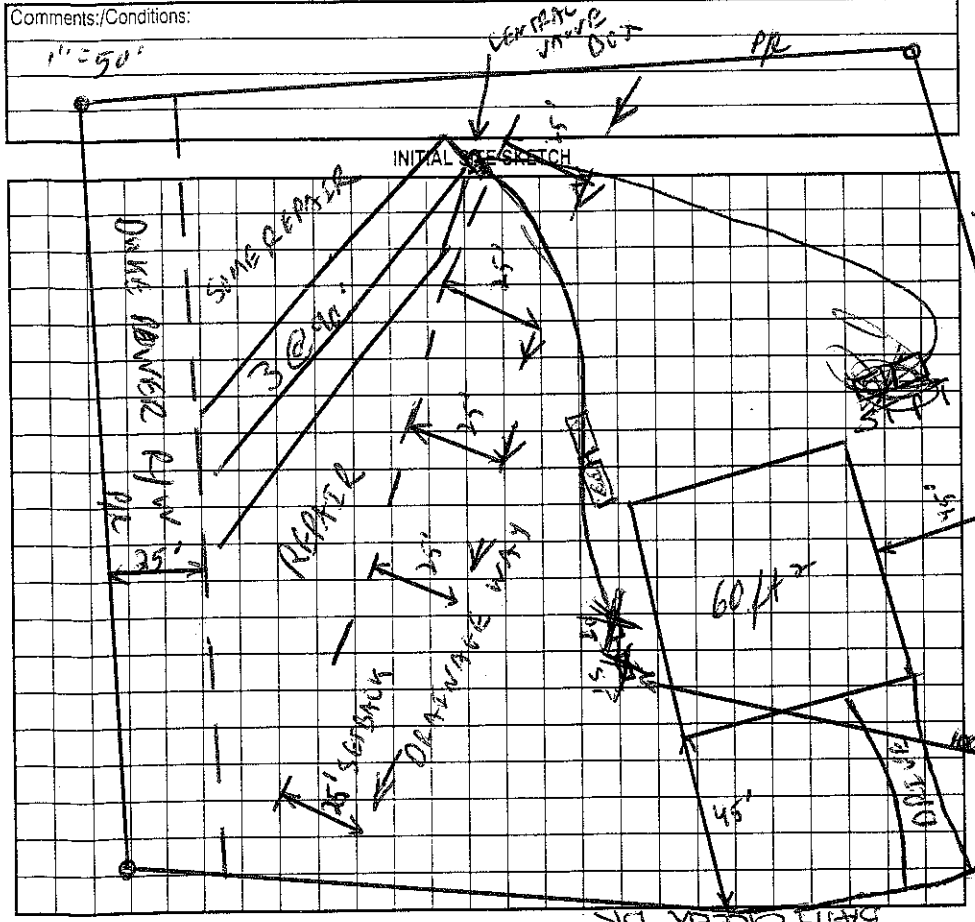

Comments:/Conditions: Hole Size = 3/16"
# of Panels = 21 per ditch
Lines checked 8/16/2002

AS BUILT SKETCH

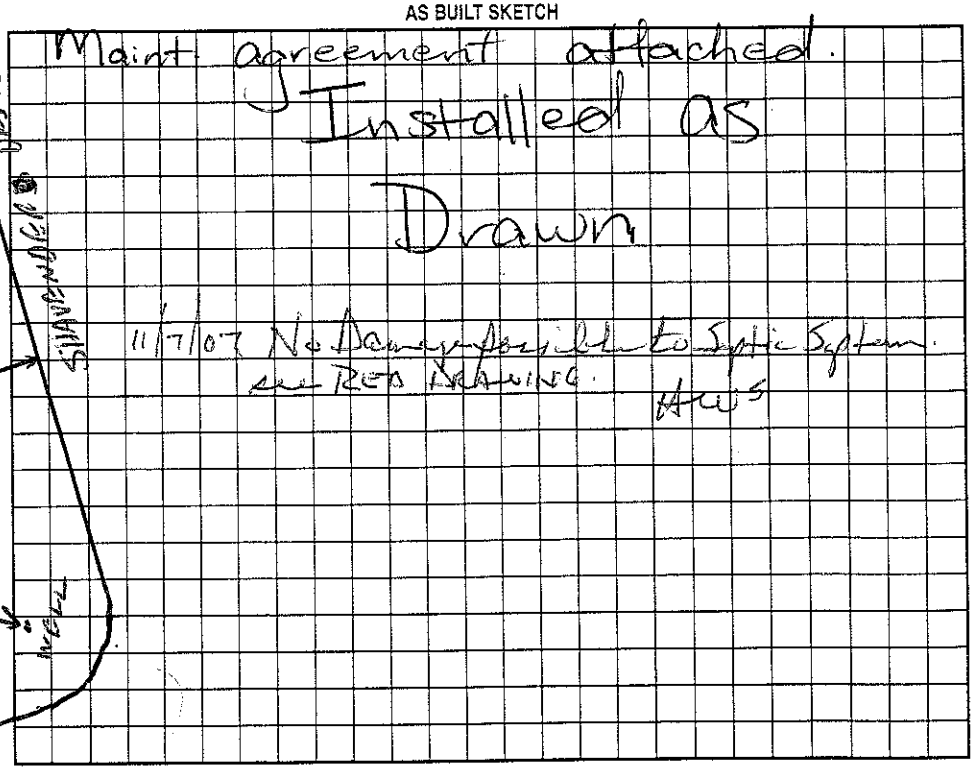

Permit can be suspended or revoked if any false information is supplied toward securing the permit/any unauthorized changes are made to the site/any unauthorized changes are made in the installation of the system. Improvement Permit with plat valid without expiration. Improvement Permit with site plan valid for sixty months. Authorization to Construct is valid for a period equal to that of Improvement Permit – not to exceed sixty months.

Signed: date 7-26-01 Installed by: Richard Abernathy

Improvement Permit by: RS date 6/14/01 Operation Permit by: RS date 9/23/2002

Authorization to Construct by: RS date 2/22/02 Existing System Inspection by: date

HEALTH DEPT. COPY: WHITE OWNER COPY (FINAL): YELLOW OWNER COPY (INITIAL): PINK