IREDELL COUNTY HEALTH DEPARTMENT

STATESVILLE 704-878-5305 50.00 Paid MOORESVILLE 704-664-5281

IMPROVEMENT PERMIT / AUTHORIZATION TO CONSTRUCT / OPERATION PERMIT / EXISTING SYSTEM INSPECTION

PERMIT# 91275 PIN# ~~4627819 014 PT~~ 4627916535 DATE 3/12/01

OWNER OR CONTRACTOR The Dupont Group Inc PHONE: Business 660-0402 Home

ADDRESS 117 Sycamore Slope Ln. Mooresville NC 28117

LOCATION Brawley School R Blume, L Beaten Path, L Cicero, L Shavender on Lt

SUBDIVISION Shavenders Bluff BLOCK / SECTION LOT 93 LOT AREA 1.14 AC SITE CLASS. PS DESIGN FLOW 450 L.T.A.R. 0.3

Septic Tank: 1000 Gallons; STB 1012 Date 1/15/01

Pump Tank: Gallons; PT Date

Pump Make: Model Serial No.

Nitrification Field: No Fields 1 Square Feet 1200 Linear Feet 400

No Lines 5 @ 80' Trench Width 36" Max Trench Bottom Depth 32" Gravel Depth —

☒ New System ☐ Repair System Type: I II III IV V VI

System Description: Gravity 25% Reduc.

Repair System Description: Gravity Panel

Maintenance Agreement Required: ☐ Yes ☐ No

☒ House/Mod. Home ☐ Mobile Home ☐ Business ☐ Other

No. Bedrooms 4 No. Bathrooms 3 No. Employees


☐ Slab ☐ Crawl Space ☒ Basement w/plumbing ☐ Basement wo/plumbing

Water Supply: ☒ Individual ☐ Public ☐ Community

Comments:/Conditions:

Comments:/Conditions:

INITIAL SITE SKETCH

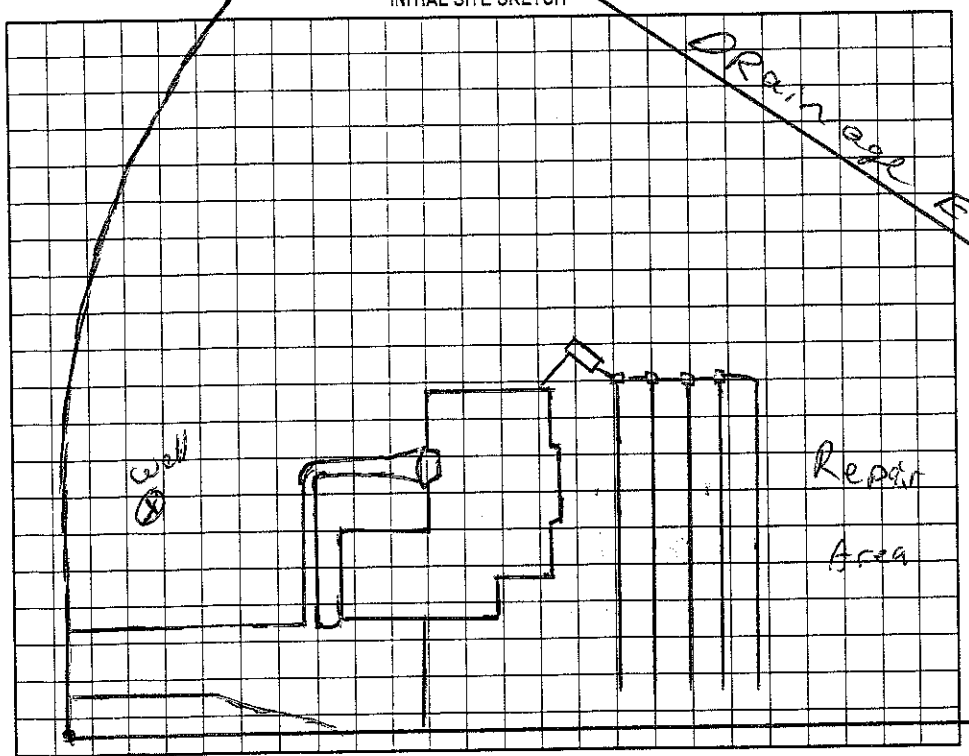

AS BUILT SKETCH

Permit can be suspended or revoked if any false information is supplied toward securing the permit/any unauthorized changes are made to the site/any unauthorized changes are made in the installation of the system. Improvement Permit with plat valid without expiration. Improvement Permit with site plan valid for sixty months. Authorization to Construct is valid for a period equal to that of Improvement Permit -- not to exceed sixty months.

Signed: date 3/12/01

Improvement Permit by: RSI date 3/12/01

Authorization to Construct by: RSI date 3/12/01

Installed by: Richard Abernathy

Operation Permit by: RSI date 3/14/01

Existing System Inspection by: date

HEALTH DEPT. COPY: WHITE OWNER COPY (FINAL): YELLOW OWNER COPY (INITIAL): PINK