2,00

IREDELL COUNTY HEALTH DEPARTMENT

STATESVILLE 704-878-5305 MOORESVILLE 704-664-5281

IMPROVEMENT PERMIT / AUTHORIZATION TO CONSTRUCT / OPERATION PERMIT / EXISTING SYSTEM INSPECTION

PERMIT# 070871 PIN# 4627918293 DATE 1/7/99

OWNER OR CONTRACTOR SHAVENDER'S DEV GROUP PHONE: Business 663-6405 T JACOBS Home

ADDRESS 1143-D EXECUTIVE CERCLE - CARY NC 28511

LOCATION BRAWLEY SCHOOL RD - TR BLUME - TL BEATEN PATH - ON LT B-4 FOREST COVE

SUBDIVISION SHAVENDERS BLUFF BLOCK / SECTION LOT 16 LOT AREA .694 AC SITE CLASS. PS DESIGN FLOW 360 GPD L.T.A.R. .360 / FT

Septic Tank: 1000 Gallons; STB 794 Date 2/22/99
Pump Tank: Gallons; PT Date
Pump Make: Model Serial No.
Nitrification Field: No Fields 1 Square Feet 900 Linear Feet 300
No Lines 4 @ 75' Trench Width 36" Max Trench Bottom Depth 36" Gravel Depth N/A

☑ New System ☐ Repair System Type: I, II, (III) IV, V, VI
System Description: GRAVITY CHAMBERS ORIG
Repair System Description: SAME
Maintenance Agreement Required: ☐ Yes ☑ No

☐ House/Mod. Home No. Bedrooms 3
☐ Mobile Home No. Bathrooms 3
☐ Business No. Employees
☐ Other
☐ Slab ☑ Crawl Space ☐ Basement w/plumbing ☐ Basement wo/plumbing


Water Supply: ☑ Individual ☐ Public ☐ Community

Comments:/Conditions:


1"=40'

Comments:/Conditions:

INITIAL SITE SKETCH

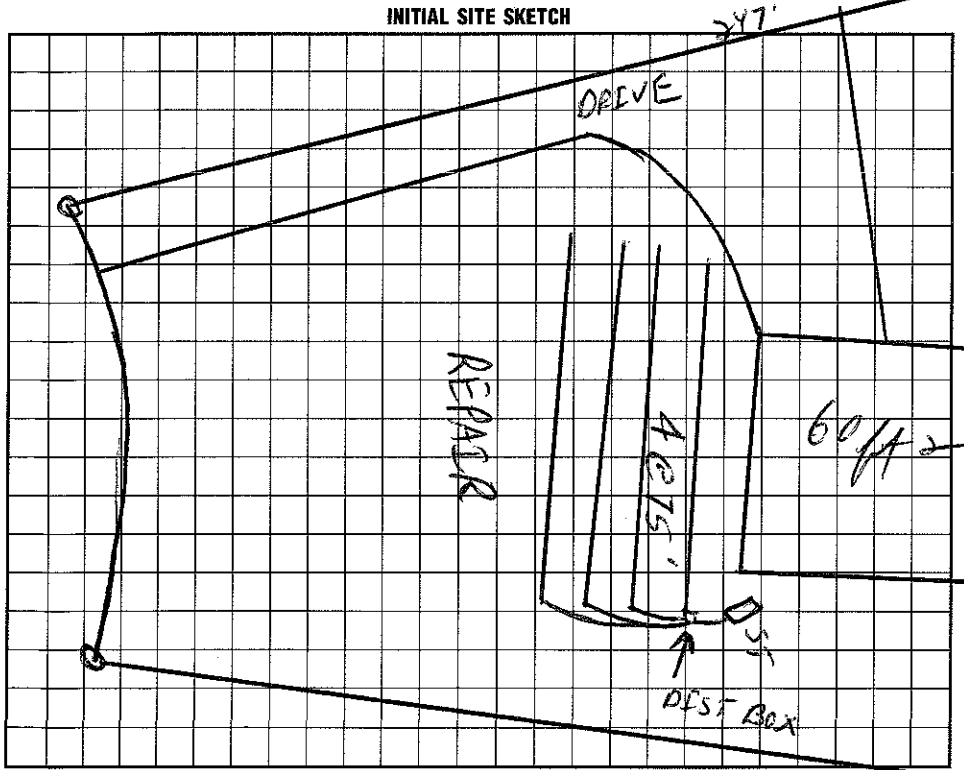

AS BUILT SKETCH

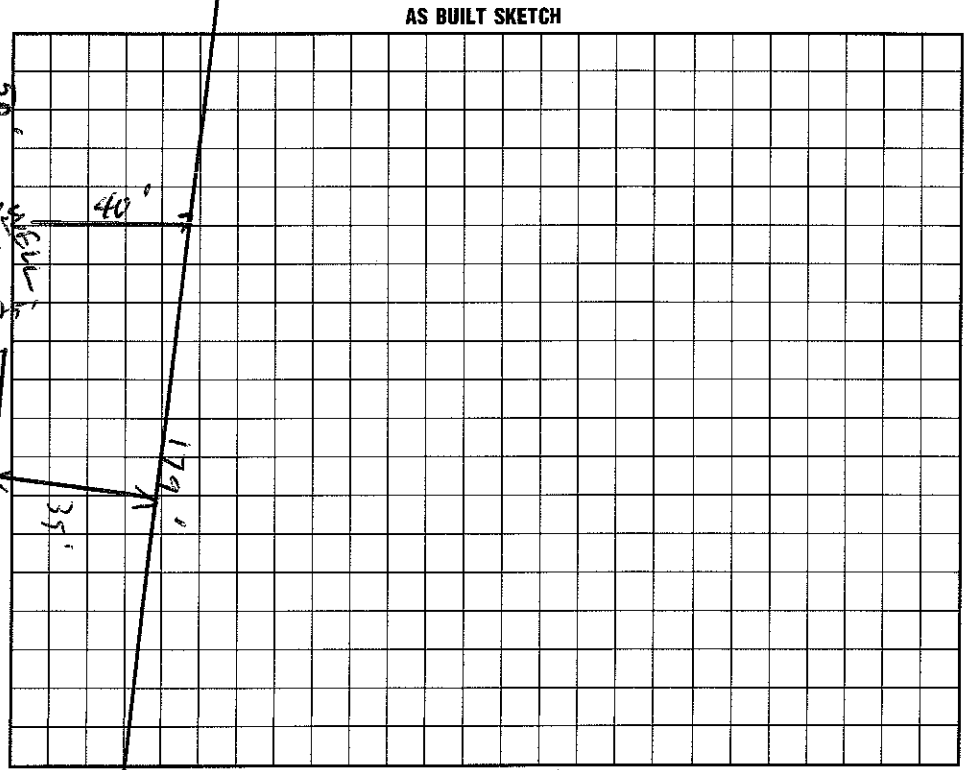

I understand that this permit can be suspended or revoked if any false information is supplied toward securing the permit/any unauthorized changes are made to the site/any unauthorized changes are made in the installation of the system. Improvement Permit with plat valid without expiration. Improvement Permit with site plan valid for sixty months. Authorization to Construct is valid for a period equal to that of Improvement Permit – not to exceed sixty months.

Signed: date 1-11-99 Installed by: FJ Ervin Septic

Improvement Permit by: date 1/7/99 Operation Permit by: date 3/20/99

Authorization to Construct by: date 1/7/99 Existing System Inspection by: date

HEALTH DEPT. COPY: WHITE INSPECTION COPY (FINAL): GREEN OWNER COPY (FINAL): YELLOW INSPECTION COPY (INITIAL): PINK OWNER COPY (INITIAL): GOLD