IREDELL COUNTY HEALTH DEPARTMENT

STATESVILLE 704-878-5305 50.00 Paid 11:30 MOORESVILLE 704-664-5281

IMPROVEMENT PERMIT / AUTHORIZATION TO CONSTRUCT / OPERATION PERMIT / EXISTING SYSTEM INSPECTION

PERMIT# 067758 PIN# 4627 91 2791 4627-92-1746 DATE 12/14/01

OWNER OR CONTRACTOR Kevin Huff Stetler PHONE: Business Home 704-361-8951

ADDRESS 147 Dobbin Cir Mooresville NC 28117 - 135 DOBBIN CT.

LOCATION Brawley Sch, TR Blume, TL Beaty Path TL Dobbin 5th on LT

SUBDIVISION Shavenders Bluff BLOCK / SECTION LOT 152 LOT AREA 0.79 AC SITE CLASS. PS DESIGN FLOW 600 L.T.A.R. 0.55

Septic Tank: 1000 Gallons; STB 794 Date 6/12/02 ☒ New System ☐ Repair System Type: I, II, III, IV, V, VI

Pump Tank: 1000 Gallons; PT 27 Date 6/25/02 System Description: Pump 25% Reduction

Pump Make: Myers Model ME3F-11 Serial No: 2622900800 Repair System Description: LP Pond

Nitrification Field: No Fields 1 Square Feet 1284 Linear Feet 428 Maintenance Agreement Required: ☐ Yes ☒ No

No Lines 4@107' Trench Width 36" Max Trench Bottom Depth 36" Gravel Depth —

☒ House/Mod. Home ☐ Mobile Home ☐ Business ☐ Other — No. Bedrooms 5 No. Bathrooms 3 No. Employees —


☐ Slab ☐ Crawl Space ☒ Basement w/plumbing ☐ Basement wo/plumbing

Water Supply: ☒ Individual ☐ Public ☐ Community

Comments:/Conditions:

Comments:/Conditions:

INITIAL SITE SKETCH

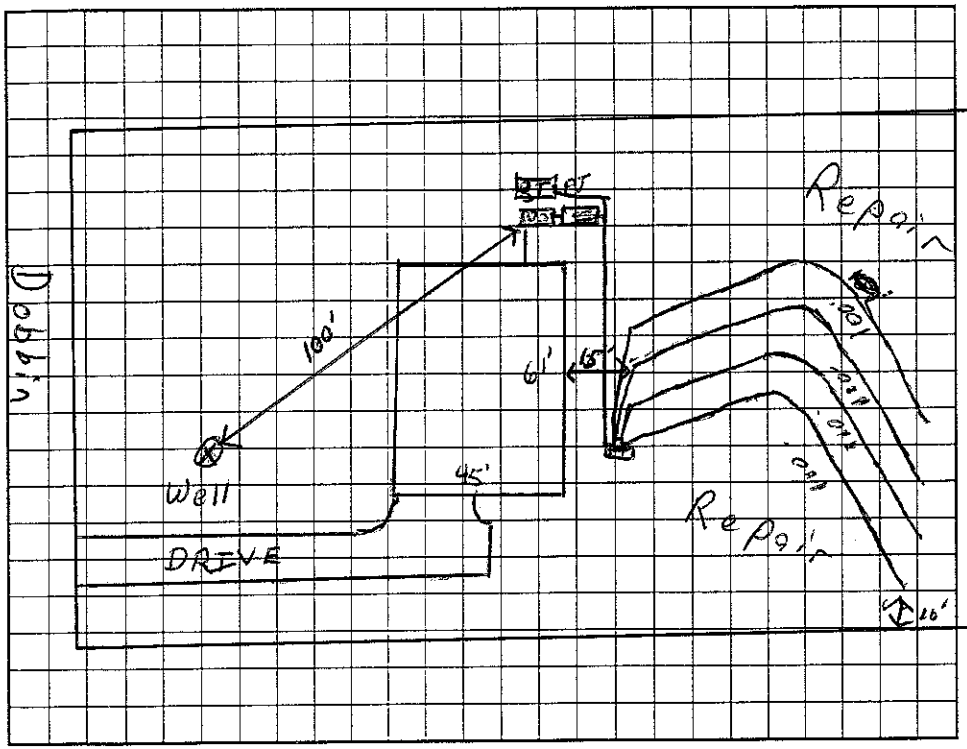

AS BUILT SKETCH

Permit can be suspended or revoked if any false information is supplied toward securing the permit/any unauthorized changes are made to the site/any unauthorized changes are made in the installation of the system. Improvement Permit with plat valid without expiration. Improvement Permit with site plan valid for sixty months. Authorization to Construct is valid for a period equal to that of Improvement Permit – not to exceed sixty months.

Signed: date 12/14/01 Installed by: Tim Ammons

Improvement Permit by: RS date 12/14/01 Operation Permit by: Wesley Sparks RS date 2/11/03

Authorization to Construct by: RS date 12/14/01 Existing System Inspection by: date

HEALTH DEPT. COPY: WHITE OWNER COPY (FINAL): YELLOW OWNER COPY (INITIAL): PINK