4627921829

IREDELL COUNTY HEALTH DEPARTMENT

STATESVILLE 704-878-5305 MOORESVILLE 704-664-5281

IMPROVEMENT PERMIT / CERTIFICATE OF COMPLETION / OPERATION PERMIT / EXISTING SYSTEM INSPECTION

PROPERTY DESCRIPTION NO. 067757 DATE 9/5/97 TAX MAP NO. 4627912791 Watershed: ☑ Yes ☐ No

OWNER OR CONTRACTOR JERRY BARNETTE PHONE: Business 241-3015 Home

ADDRESS 2056 BOLTON RD CATAWBA, NC 28609

LOCATION BRAWLEY SCHOOL RD - TR BLUME RD - TL BEATTY PATH

SUBDIVISION SHAVENDERS BLUFF BLOCK / SECTION LOT 151 LOT AREA .81 AC SITE CLASS. B DESIGN FLOW 450 L.T.A.R. .3

Septic Tank: 1000 Gallons; STB 794 Date 10/2/97

Pump Tank: Gallons; PT Date

Pump Make: Model Serial No.

Nitrification Field: No Fields 1 Square Feet 1200 Linear Feet 400

No Lines 4 @ 100' Trench Width 36" Max Trench Bottom Depth 36" Gravel Depth N/A

☑ New System ☐ Repair System Type: I, (II), III, IV, V, VI

System Description: GRAVITY CONVENTIONAL

Repair System Description: SAME

Maintenance Agreement Required: ☐ Yes ☐ No

☑ House/Mod. Home No. Bedrooms 3

☐ Mobile Home No. Bathrooms 3

☐ Business No. Employees

☐ Other


☐ Slab ☑ Crawl Space ☐ Basement w/plumbing ☐ Basement wo/plumbing

Water Supply: ☑ Individual ☐ Community ☐ Public


Comments:

Comments:

INITIAL SITE SKETCH 1" = 40'

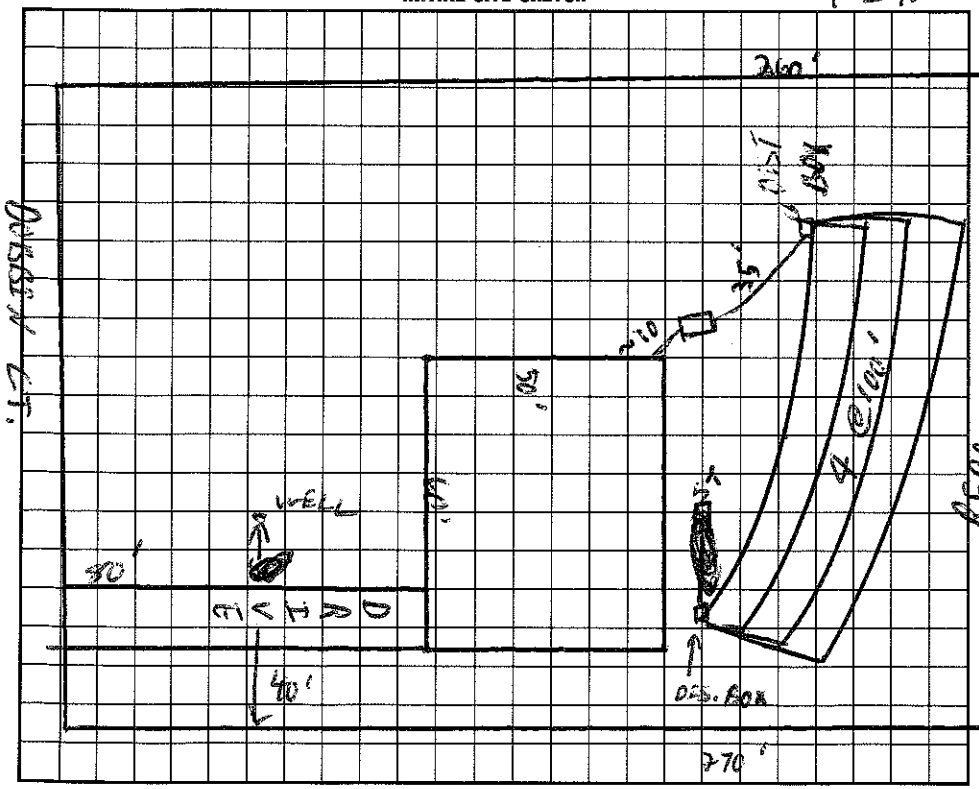

AS BUILT SKETCH

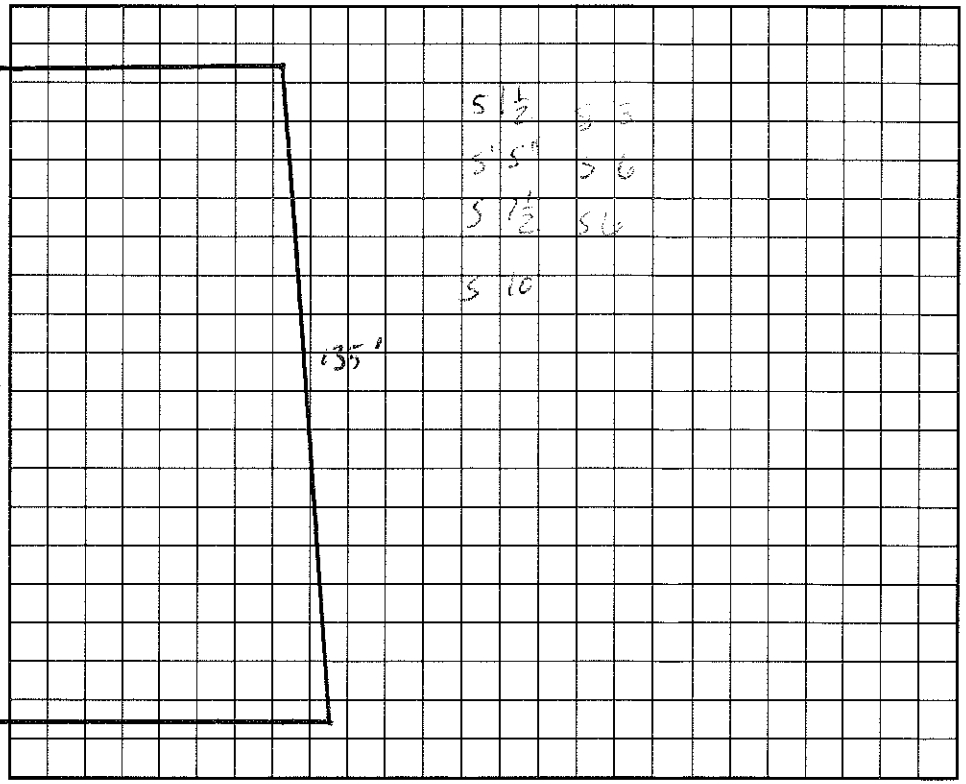

I understand that this permit can be suspended or revoked if any false information is supplied toward securing the permit/any unauthorized changes are made to the site/any unauthorized changes are made in the installation of the system. Improvement Permit is valid for 60 months from date of issuance.

Signed: Jerry Barnette

Installed by: LARRY BEAM

Improvement Permit by: C. Toby Reamer date 9/5/97

Existing System Inspection by: C. Toby Reamer date 9/8/97

Certificate of Completion by: date

Operation Permit by: C. Toby Reamer date 3/3/98

TO CONSTRUCT

HEALTH DEPT. COPY: WHITE INSPECTION COPY (FINAL): GREEN OWNER COPY (FINAL): YELLOW INSPECTION COPY (INITIAL): PINK OWNER COPY (INITIAL): GOLD