IREDELL COUNTY HEALTH DEPARTMENT

Statesville Office (704) 878-5305 Mooresville Office (704) 660-3625 PERMIT # 209542

IMPROVEMENT PERMIT / AUTHORIZATION TO CONSTRUCT / OPERATION PERMIT / EXISTING SYSTEM

PIN # 4627-92-2040

APPLICANT: PRESTIGE BUILDING APPLICANT ADDRESS: 130 OSTWALT AMITY RD.

SITE ADDRESS: 128 CICERO PHONE: ALT. PHONE:

SITE DIRECTIONS: BLUME, BEATEN PATH, CICERO, C END

SUBDIVISION: SHAVENDERS BLUFF SECTION: II LOT # 97 LOT AREA: .982 AC DESIGN FLOW: 480 L.T.A.R.: .3 (.25R)

Septic Tank 1000 (gal) STB 760 Date 6-23

Pump Tank (gal) PT Date

Pump Make Model Serial #

Nitrification Fields 1 # Lines 7 Linear Ft: 400'

Trench Width 36" Max. Trench Bottom Depth 24-36" Gravel Depth —

☒ New System ☐ Repair ☐ Expansion System Type: I II ☒ III IV V VI

System Description: 25% REDUCTION

Repair System Description: 25% REDUCTION

Maintenance Agreement Required: ☐ YES ☒ NO

☒ GRAVITY ☐ PRESSURE

☒ Residence ☐ Business ☐ Other ☐ Slab ☐ Basement w/plumbing

No. Bedrooms 4 No. Persons No. Employees ☒ Crawl Space ☐ Basement w/o plumbing

Water Supply: ☒ Private ☐ Public ☐ Community

Comments / Conditions: 4/27/15 Renewed Floor plans in Compliance with Septic plan

INITIAL SITE SKETCH

SEE PLAN BY MICHAEL ATHANAS & ASSOCIATES

AS BUILT SKETCH

CHECKED TANK & 1ST 4 LINES BA 9-15-15

CHECKED REST OF SYSTEM 9-16-15 BA

Permit can be suspended or revoked if any false information is supplied toward securing the permit / any unauthorized changes are made to the site / any unauthorized changes are made in the installation of the system. **CONTACT A LOCATOR SERVICE PRIOR TO ANY EXCAVATION**


☐ **IMPROVEMENT PERMIT** *with plat valid without expiration.* ☒ **IMPROVEMENT PERMIT** *with site plan valid for 60 mos.* ☒ **AUTHORIZATION TO CONSTRUCT** *valid for period equal to IMPROVEMENT PERMIT--not to exceed 60 mo.*

Owner / Applicant Signature: Date: 4/22/15 Installed by: GUNTER

IMPROVEMENT PERMIT by: APPROVED APR 15 2015 Date: OPERATION PERMIT by: APPROVED SEP 17 2015 Date:

AUTHORIZATION TO CONSTRUCT by: Date: 9/17/15 Existing System Inspected by: Date:

Health Dept. Copy - WHITE Applicant (Final Approval) - YELLOW Applicant (Conditional Approval) - PINK

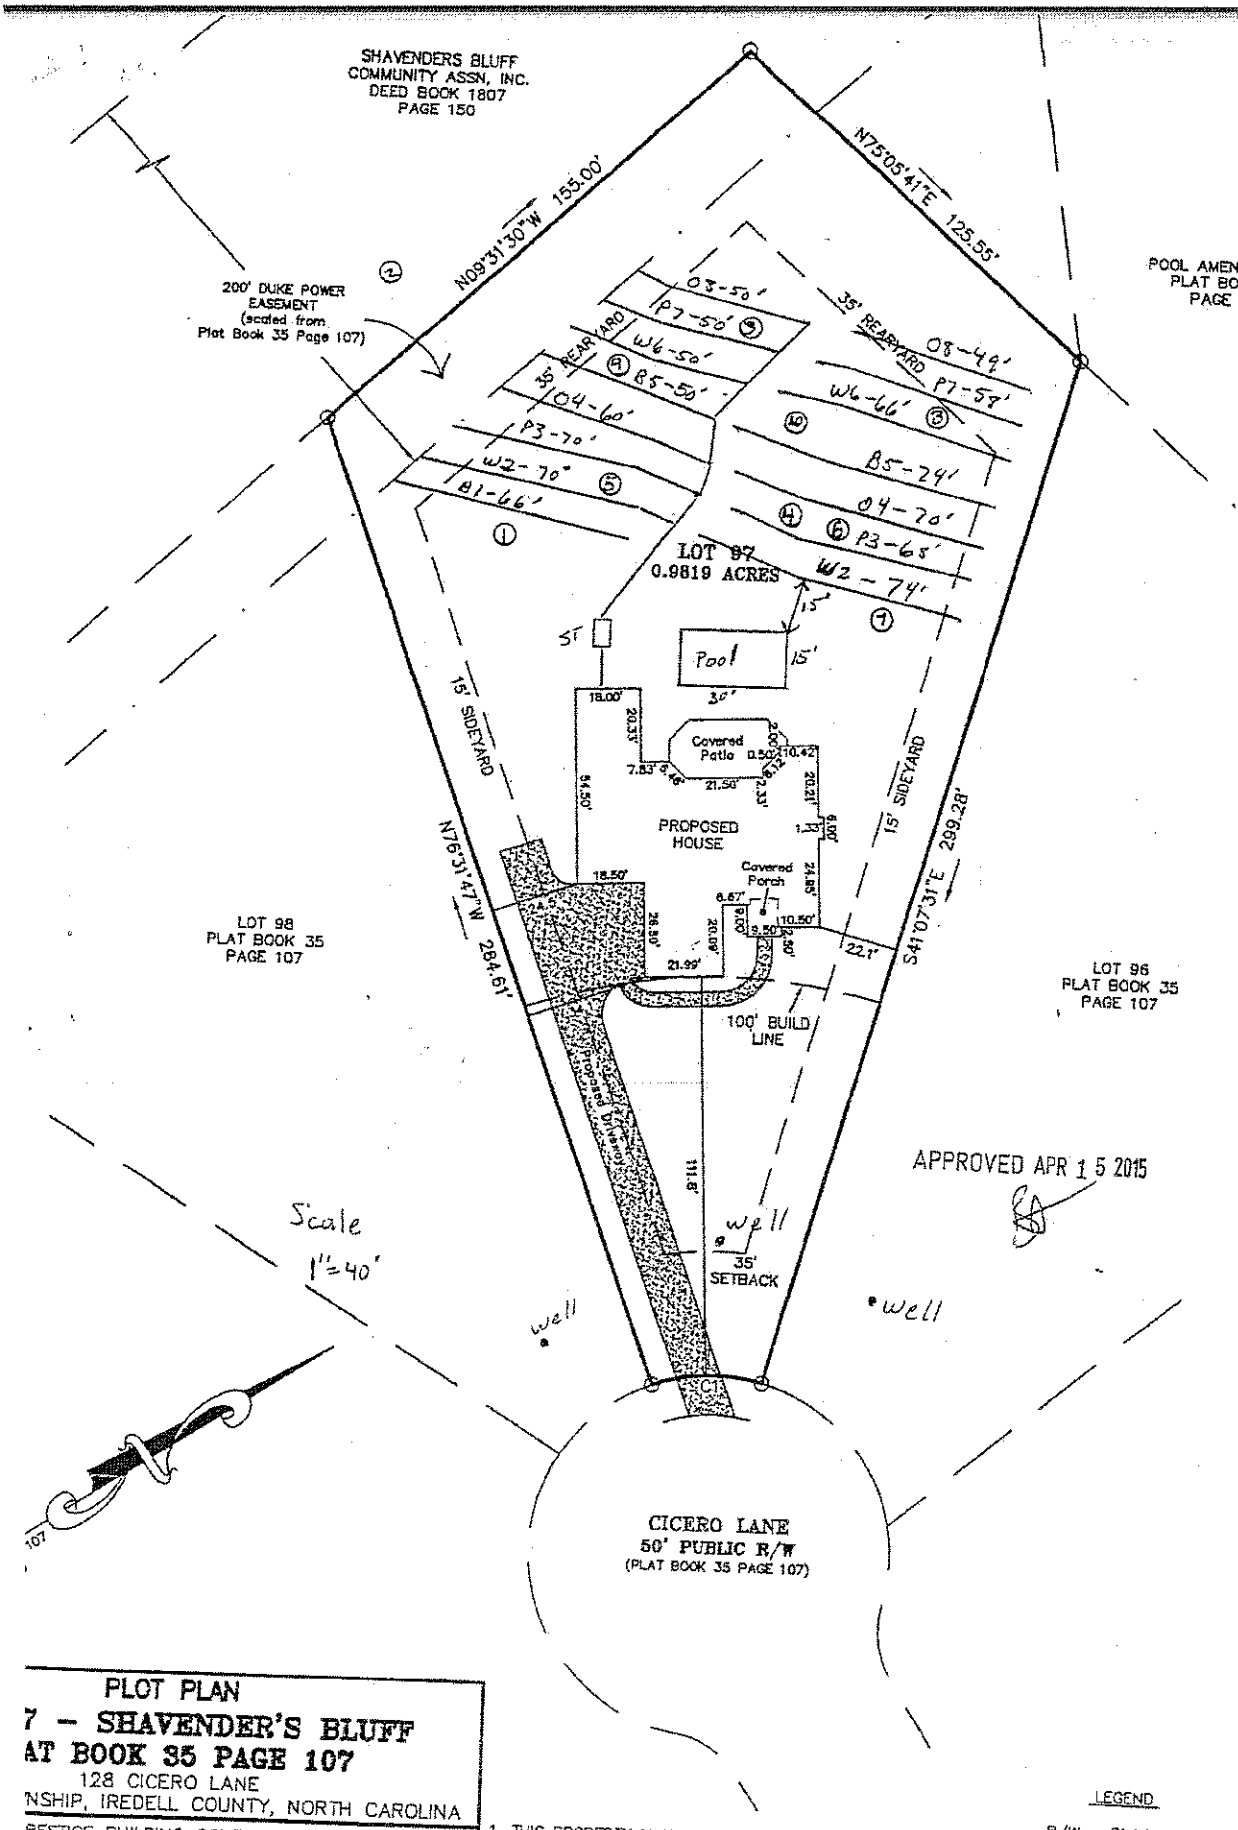

PLOT PLAN

7 – SHAVENDER'S BLUFF

AT BOOK 35 PAGE 107

128 CICERO LANE

NSHIP, IREDELL COUNTY, NORTH CAROLINA

RESTIGE BUILDING COMPANY, INC.
130-C OSTWALT AMITY ROAD
TROUTMAN, NC 28166

SON LAND SURVEYING, P.A.

NC LICENSE #: P-1021

1. THIS PROPERTY MAY BE SUBJECT TO ANY EASEMENTS, RIGHTS-OF-WAY, AND/OR RESTRICTIVE COVENANTS.
2. BOUNDARY INFORMATION BASED ON PLAT BOOK 35 PAGE 107 AS RECORDED IN THE IREDELL COUNTY REGISTER OF DEEDS. NO FIELDWORK WAS PERFORMED FOR THIS PLOT PLAN.

LEGEND

R/W = Right-of-

—∿— = Not to S

GRAPHIC S