IREDELL COUNTY HEALTH DEPARTMENT

STATESVILLE 704-878-5305 50.00 Paid MOORESVILLE 704-664-5281 4100

IMPROVEMENT PERMIT / AUTHORIZATION TO CONSTRUCT / OPERATION PERMIT / EXISTING SYSTEM INSPECTION

PERMIT# 088632/120207 PIN# ~~9627-81-9011-PF~~ 4627923094 DATE

OWNER OR CONTRACTOR Kevin Huffstetler PHONE: Business 704-361-8951 Home

ADDRESS 147 Dobbin Ln Mooresville NC 28117

LOCATION BSR, TR Blume, TL Beaton Park, TL Cicero, At end on Rt

SUBDIVISION Shoreline Bluff BLOCK / SECTION LOT 96 LOT AREA SITE CLASS. PS DESIGN FLOW 600 L.T.A.R. 0.5

Septic Tank: 1500 Gallons; STB 338 Date 8-29-04

Pump Tank: Gallons; PT Date

Pump Make: Model Serial No.

Nitrification Field: No Fields 1 Square Feet 1600 Linear Feet 533'

No Lines 4@133' Trench Width 36" Max Trench Bottom Depth 36" Gravel Depth —

☒ New System ☐ Repair System Type: I, II, (III), IV, V, VI

System Description: Gravity 25% Reduct.

Repair System Description: Pump Panel Block

Maintenance Agreement Required: ☐ Yes ☒ No

☒ House/Mod. Home No. Bedrooms 5

☐ Mobile Home No. Bathrooms 4.5

☐ Business No. Employees

☐ Other

☐ Slab ☐ Crawl Space ☒ Basement w/plumbing ☐ Basement wo/plumbing

Water Supply: ☒ Individual ☐ Public ☐ Community


Comments:/Conditions:

1"=50'


Comments:/Conditions: ST Checked 10/22/04 MD

Lines Checked 10/26/04 MD

INITIAL SITE SKETCH

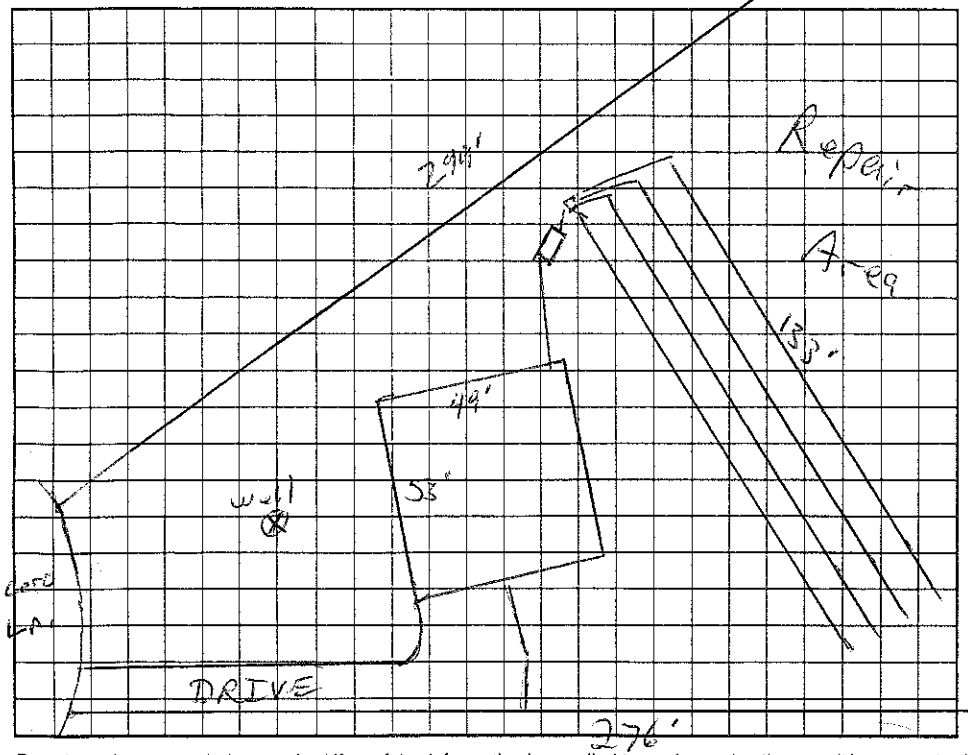

AS BUILT SKETCH

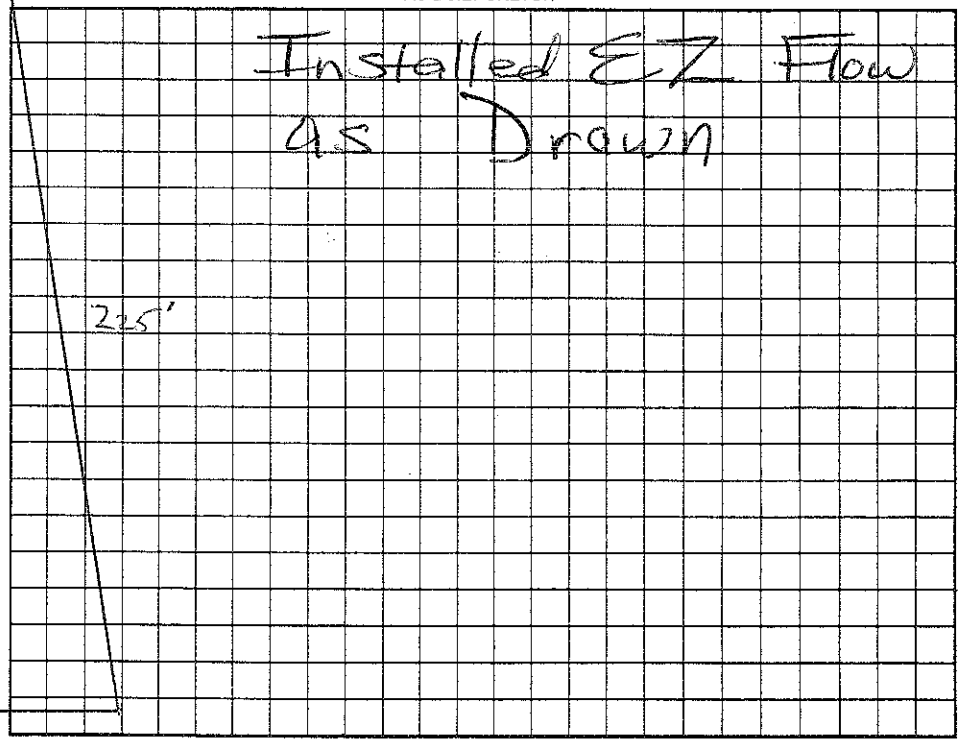

Permit can be suspended or revoked if any false information is supplied toward securing the permit/any unauthorized changes are made to the site/any unauthorized changes are made in the installation of the system. Improvement Permit with plat valid without expiration. Improvement Permit with site plan valid for sixty months. Authorization to Construct is valid for a period equal to that of Improvement Permit – not to exceed sixty months.

Signed: date 3/19/04 Installed by: Tim Ammons RS

Improvement Permit by: RS date 3/15/04 Operation Permit by: Maria H Nelson date 10/26/04

Authorization to Construct by: RS date 3/15/04 Existing System Inspection by: date

HEALTH DEPT. COPY: WHITE OWNER COPY (FINAL): YELLOW OWNER COPY (INITIAL): PINK