IREDELL COUNTY HEALTH DEPARTMENT

STATESVILLE 704-878-5305 MOORESVILLE 704-664-5281

IMPROVEMENT PERMIT / CERTIFICATE OF COMPLETION / OPERATION PERMIT / EXISTING SYSTEM INSPECTION

PROPERTY DESCRIPTION NO. ~~06 7749~~ 087612 DATE 7/9/97 TAX MAP NO. ~~462 7412 7441~~ 4627923897 Watershed: ☒ ~~Yes~~ ☐ No

OWNER OR CONTRACTOR ~~SHAVENDER'S DEVELOPMENT~~ ZARING HOMES PHONE: Business 370-7707 Home 663-6905 - T JACKS

ADDRESS ~~447-D EXECUTIVE CIR.~~ 1043 E MOREHEAD ST CHARLOTTE, NC. 28204

LOCATION BRAWLEY SCHOOL RD - BLUME RD - TL Benton Path TL Debnam 3RD on R

SUBDIVISION SHAVENDER'S BUFF BLOCK / SECTION 2 LOT 144 LOT AREA .70 AC SITE CLASS. PS DESIGN FLOW ~~440 GPD~~ L.T.A.R. .3600 SQ FT

Septic Tank: 1000 Gallons; STB 317 Date 5/7/00

Pump Tank: 1000 Gallons; PT 317 Date 4/9/00

Pump Make: Bould Model WE0-311N Serial No. L9945078

Nitrification Field: No Fields 1 Square Feet 540 Linear Feet 370

No Lines 5 Trench Width 24" Max Trench Bottom Depth 36" Gravel Depth N/A

☑ New System ☐ Repair System Type: I, II, III, (IV), V, VI

System Description: PUMP PANEL

Repair System Description: SAME

Maintenance Agreement Required ☑ Yes ☐ No

☑ House/Mod. Home No. Bedrooms 4

☐ Mobile Home No. Bathrooms 3

☐ Business No. Employees ____

☐ Other ____

☐ Slab ☑ Crawl Space ☐ Basement w/plumbing ☐ Basement wo/plumbing


Water Supply: ☑ ~~Individual~~ ☐ Community ☐ Public

Comments: NEW HOUSE LOCATION - OK - 2/25/00 AWS


Comments:

1" = 40'

INITIAL SITE SKETCH

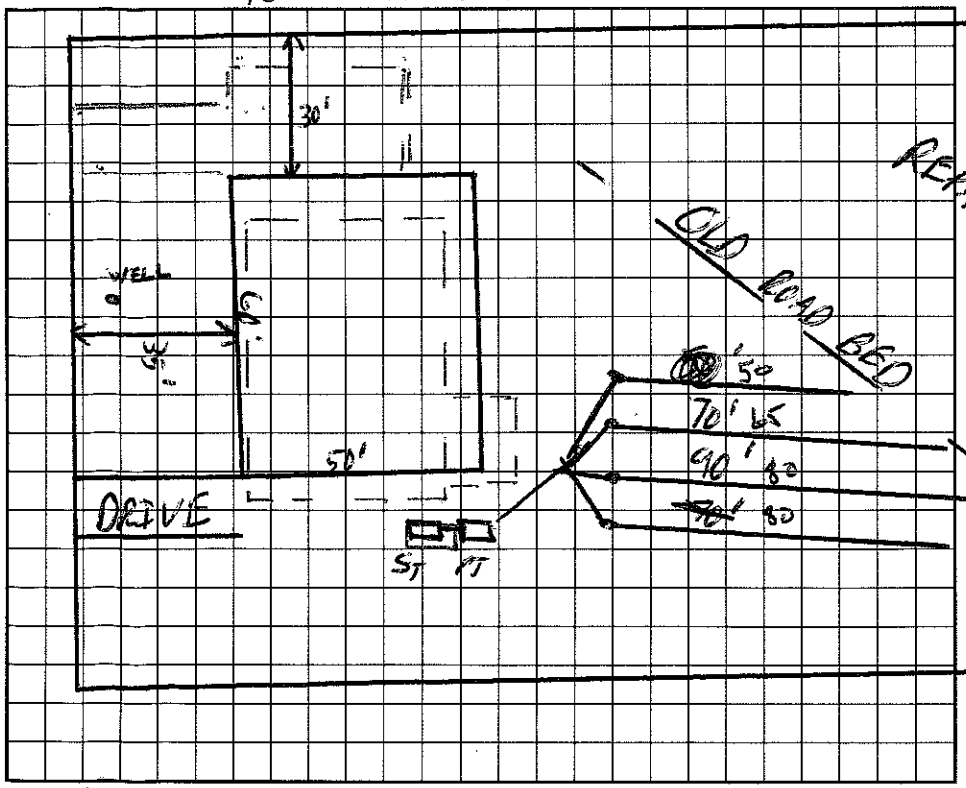

AS BUILT SKETCH

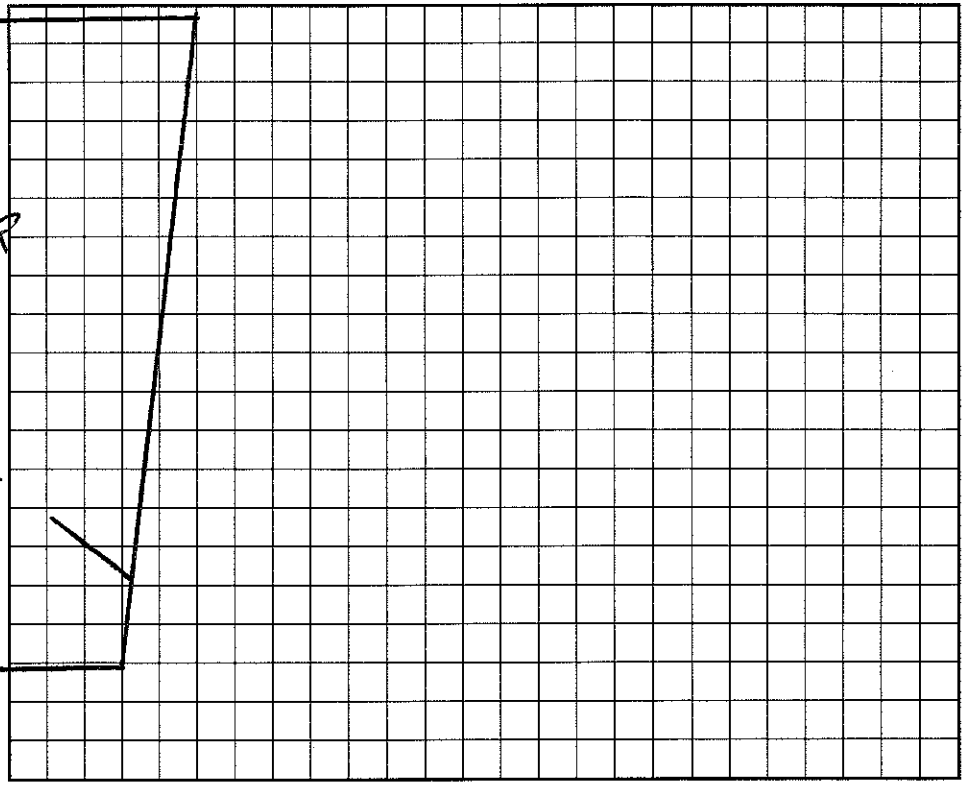

I understand that this permit can be suspended or revoked if any false information is supplied toward securing the permit/any unauthorized changes are made to the site/any unauthorized changes are made in the installation of the system. Improvement Permit is valid for 60 months from date of issuance.

Signed: Leonard A. Sullivan

Improvement Permit by: [signature] date 7/9/97

~~Construction~~ Inspection by: Wesley Sparks RS date 2/8/00

Installed by: Bob McCanney

Certificate of Completion by: Wesley Sparks RS. date 6/15/00

Operation Permit by: Wesley Sparks RS. date 6/15/00

HEALTH DEPT. COPY: WHITE INSPECTION COPY (FINAL): GREEN OWNER COPY (FINAL): YELLOW INSPECTION COPY (INITIAL): PINK OWNER COPY (INITIAL): GOLD