IREDELL COUNTY HEALTH DEPARTMENT

AUTHORIZATION TO CONSTRUCT

~~4627924527~~ 4627924527

STATESVILLE 704-878-5305 MOORESVILLE 704-664-5281

IMPROVEMENT PERMIT / ~~CERTIFICATE OF COMPLETION~~ / OPERATION PERMIT / EXISTING SYSTEM INSPECTION

PROPERTY DESCRIPTION NO. 067741 DATE 8/26/97 TAX MAP NO. ~~4627924527~~ Watershed: ☑ Yes ☐ No

OWNER OR CONTRACTOR DOUG EASTER PHONE: Business Home

ADDRESS PO BOX 6043 MOORESVILLE 28115

LOCATION BRAWLEY SCHOOL RD TR BLUME RD - TL BEATEN PATH - TL DOBBIN CT - 2nd ON RT

SUBDIVISION SHAVENOGER'S BLUFF BLOCK / SECTION LOT 142 LOT AREA .75AC. SITE CLASS. RS DESIGN FLOW 360 L.T.A.R. .3

Septic Tank: 1000 Gallons; STB 825 Date 9/16/97

Pump Tank: Gallons; PT Date

Pump Make: Model Serial No.

Nitrification Field: No Fields 1 Square Feet 900 Linear Feet 300

No Lines 5@60' Trench Width 36 Max Trench Bottom Depth 36" Gravel Depth N/A

☑ New System ☐ Repair System Type: I, II, III, IV, V, VI

System Description: GRAVITY CHAMBERED OR HDS

Repair System Description: SAME

Maintenance Agreement Required: ☐ Yes ☑ No

☑ House/Mod. Home No. Bedrooms 3

☐ Mobile Home No. Bathrooms 3

☐ Business No. Employees

☐ Other


☐ Slab ☑ Crawl Space ☐ Basement w/plumbing ☐ Basement wo/plumbing

Water Supply: ☑ Individual ☐ Community ☐ Public


Comments:

Comments:

INITIAL SITE SKETCH

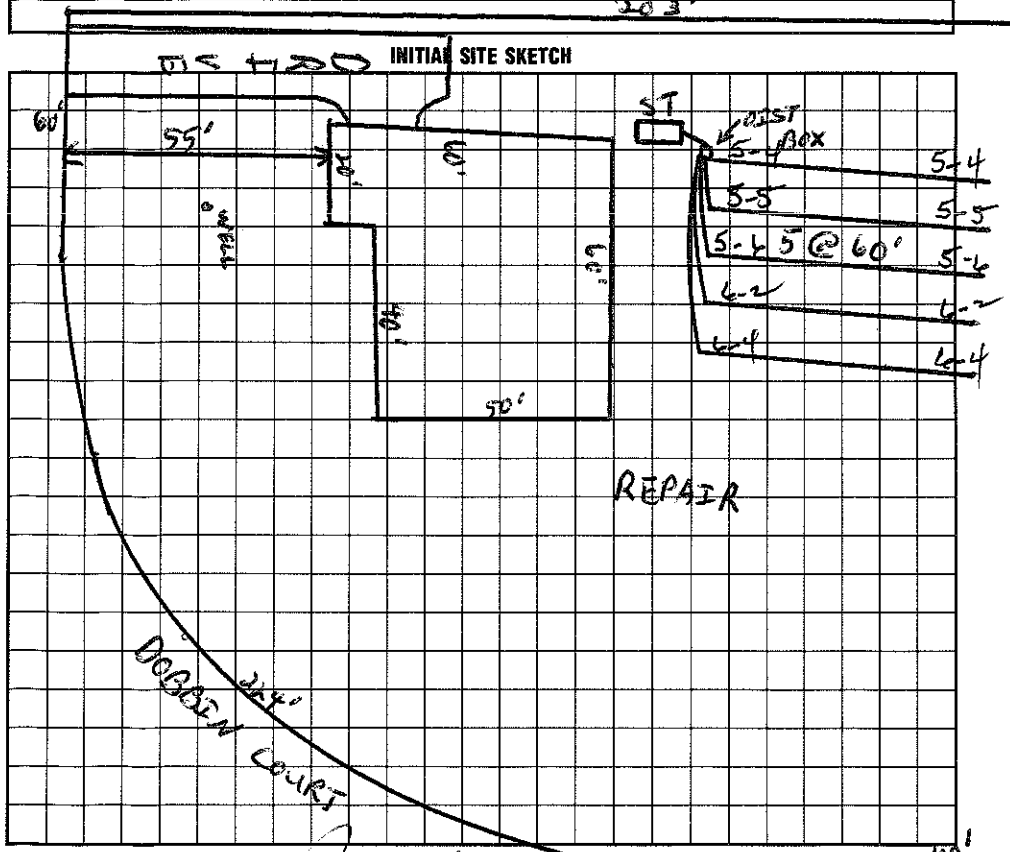

AS BUILT SKETCH

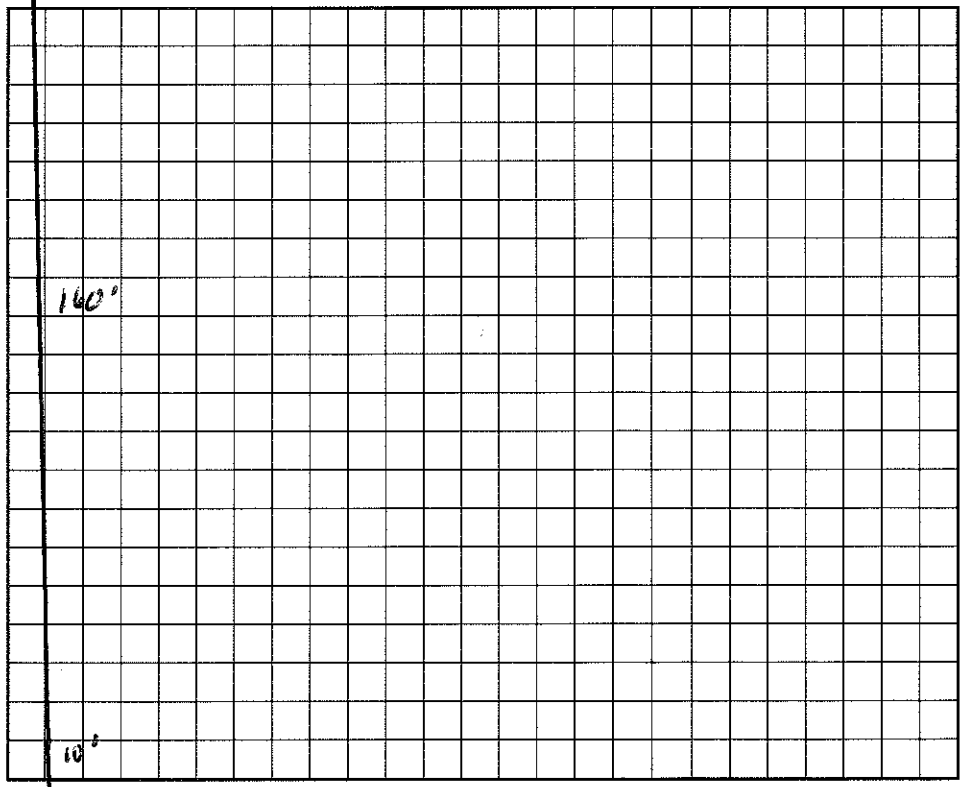

I understand that this permit can be suspended or revoked if any false information is supplied toward securing the permit/any unauthorized changes are made to the site/any unauthorized changes are made in the installation of the system. Improvement Permit is valid for 60 months from date of issuance.

Signed: Agent 9/2/97

Improvement Permit by: date 9/26/97

AUTHORIZATION ~~Existing System Inspection~~ by: date 9/26/97

TO CONSTRUCT

Installed by: Kenny Williams

Certificate of Completion by: Wesley Sparks RS date 12/18/97

Operation Permit by: Wesley Sparks RS. date 12/18/97

HEALTH DEPT. COPY: WHITE INSPECTION COPY (FINAL): GREEN OWNER COPY (FINAL): YELLOW INSPECTION COPY (INITIAL): PINK OWNER COPY (INITIAL): GOLD