Paid 125.00 6-5-00

IREDELL COUNTY HEALTH DEPARTMENT

STATESVILLE 704-878-5305 MOORESVILLE 704-664-5281

IMPROVEMENT PERMIT / AUTHORIZATION TO CONSTRUCT / OPERATION PERMIT / EXISTING SYSTEM INSPECTION

PERMIT# 1158588630 PIN# ~~4627-84-9014~~ PT 4627925034 DATE 4/28/00

OWNER OR CONTRACTOR SHAVENDERS DEV. GRP | ALLEN KUCZMARSKI PHONE: Business 919-460-0270 Home

ADDRESS 1143-D EXECUTIVE DRIVE. CARY NC 27511

LOCATION BRAWLEY SCHOOL - TR BLUME - TL BEATEN PATH - TL CICERO - ON RT

SUBDIVISION SHAVENDERS BLUFF BLOCK / SECTION LOT 95 LOT AREA SITE CLASS. PS DESIGN FLOW 480 GPD L.T.A.R. .3 gpd/sq ft

Septic Tank: 1000 Gallons; STB 1000? Date 10/16/03
Pump Tank: Gallons; PT Date
Pump Make: Model Serial No.
Nitrification Field: No Fields 1 Square Feet 1200 Linear Feet 400
No Lines 5@80' Trench Width 36" Max Trench Bottom Depth 36" Gravel Depth N/A

☑ New System ☐ Repair System Type: I, II, III, IV, V, VI
System Description: GRAVITY 25% REDUCTION
Repair System Description: SAME
Maintenance Agreement Required: ☐ Yes ☑ No


☑ House/Mod. Home No. Bedrooms 4
☐ Mobile Home No. Bathrooms 4
☐ Business No. Employees
☐ Other
☐ Slab ☑ Crawl Space ☐ Basement w/plumbing ☐ Basement wo/plumbing

Water Supply: ☑ Individual ☐ Public ☑ Community


Comments:/Conditions:

Comments:/Conditions:

INITIAL SITE SKETCH 1"=40'

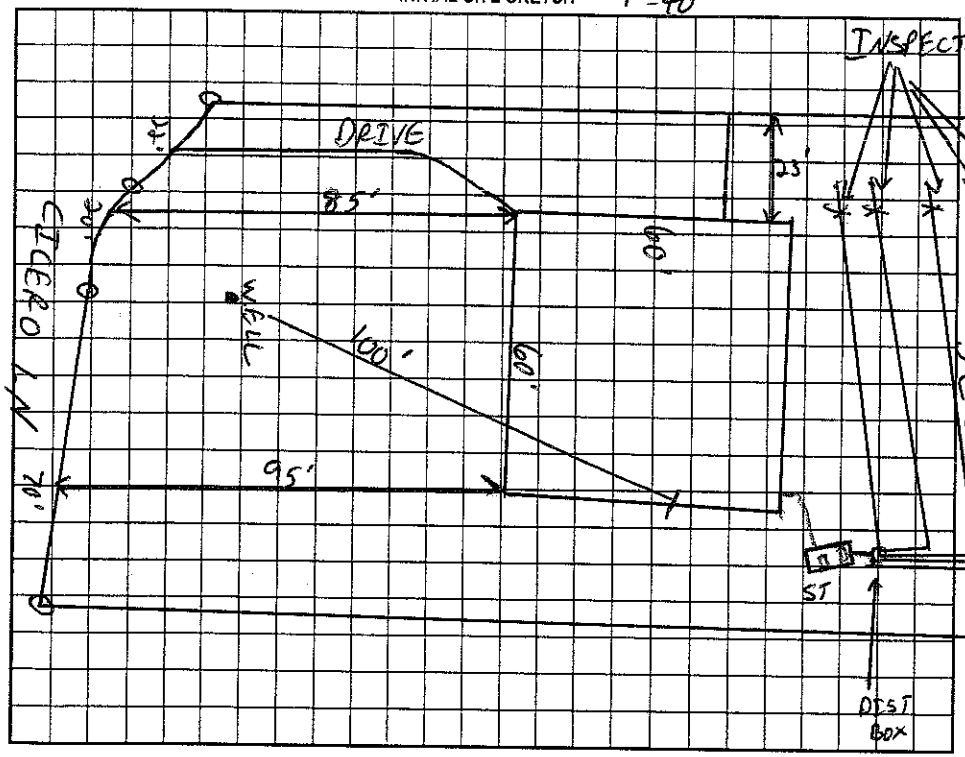

AS BUILT SKETCH

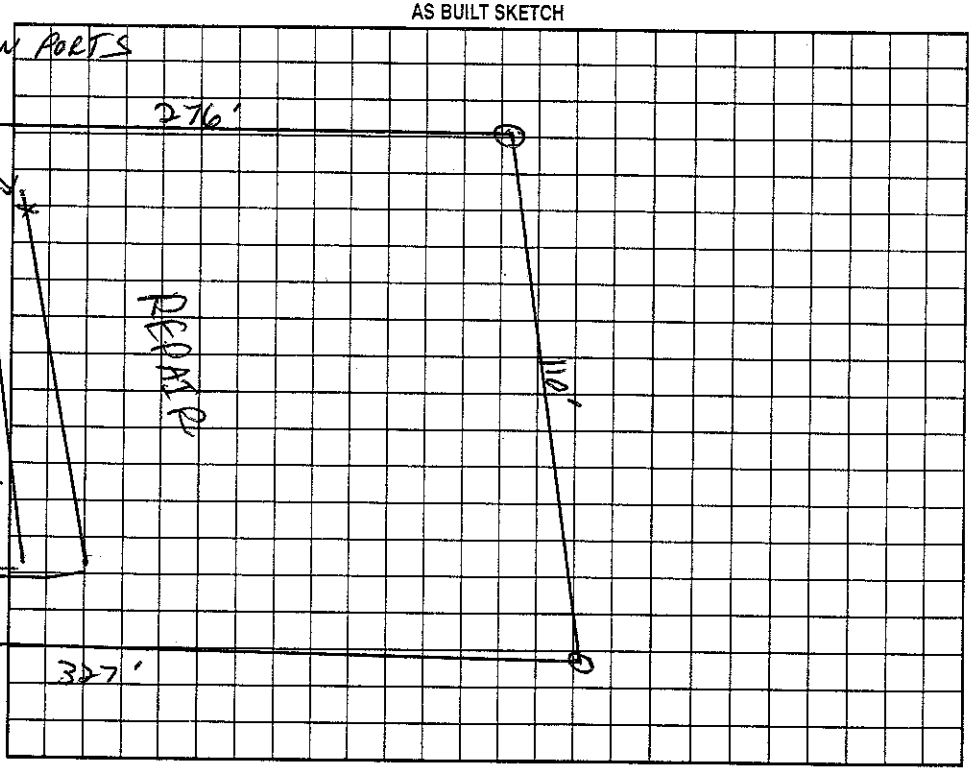

Permit can be suspended or revoked if any false information is supplied toward securing the permit/any unauthorized changes are made to the site/any unauthorized changes are made in the installation of the system. Improvement Permit with plat valid without expiration. Improvement Permit with site plan valid for sixty months. Authorization to Construct is valid for a period equal to that of Improvement Permit – not to exceed sixty months.

Signed: _____ date 6/5/00 Installed by: A+S Hill Grading

Improvement Permit by: _____ RS date 4/28/00 Operation Permit by: Wesley Sparks R.S. date 1/15/04

Authorization to Construct by: Wesley Sparks R.S. date 8/7/03 Existing System Inspection by: _____ date _____

HEALTH DEPT. COPY: WHITE OWNER COPY (FINAL): YELLOW OWNER COPY (INITIAL): PINK