IREDELL COUNTY HEALTH DEPARTMENT

Statesville Office (704) 878-5305 Mooresville Office (704) 660-3625 PERMIT # 173728

IMPROVEMENT PERMIT / AUTHORIZATION TO CONSTRUCT / OPERATION PERMIT / EXISTING SYSTEM

PIN # 4627926035

APPLICANT: BRYAN WAGNER APPLICANT ADDRESS: 8029 MAIECON DR NC 28078

SITE ADDRESS: 116 CICERO LN MOORESVILLE NC 28117 PHONE: ALT. PHONE: 704 661 7065

SITE DIRECTIONS: BRAWLEY SCHOOL - TR BLUME - TL HEAVEN PATH - TL CICERO - ON RT

SUBDIVISION: SHAVENDER'S BLUFF SECTION: II LOT # 94 LOT AREA: .733AC DESIGN FLOW: 360 L.T.A.R.: .3

Septic Tank 1000 (gal) STB 794 Date 12-11-14
Pump Tank (gal) PT Date
Pump Make Model Serial #
Nitrification Fields 1 # Lines 3 Linear Ft. 300
Trench Width 36" Max. Trench Bottom Depth 20" Gravel Depth N/A

☑ New System ☐ Repair ☐ Expansion System Type: I II (III) IV V VI
System Description: GRAVITY 25% REDUCTION
Repair System Description: LP PPBPS
Maintenance Agreement Required: ☐ YES ☑ NO
☑ GRAVITY ☐ PRESSURE

☑ Residence No. Bedrooms 3
☐ Business No. Persons 6
☐ Other No. Employees
☐ Slab ☑ Crawl Space
☐ Basement w/plumbing ☐ Basement w/o plumbing

Water Supply: ☑ Private ☐ Public ☐ Community

Comments / Conditions: 9/13/13 Reviewed Floor Plans in compliance with Original plan
★ 1/2 Bath by Study, fixed Windows in Bonus Rm

INITIAL SITE SKETCH

SEE MECHAEC ATHANAS & ASSOCIATES PLAN

AS BUILT SKETCH

CHECKED MAR 11 2014

INSTALLED 3 @ 100'

Permit can be suspended or revoked if any false information is supplied toward securing the permit / any unauthorized changes are made to the site / any unauthorized changes are made in the installation of the system. **CONTACT A LOCATOR SERVICE PRIOR TO ANY EXCAVATION**

☐ **IMPROVEMENT PERMIT** *with plat valid without expiration.* ☑ **IMPROVEMENT PERMIT** *with site plan valid for 60 mos.* ☐ **AUTHORIZATION TO CONSTRUCT** *valid for period equal to IMPROVEMENT PERMIT--not to exceed 60 mo.*


Owner / Applicant Signature: Date: 9/13/13 Installed by: RICHARD ABERNATHY

IMPROVEMENT PERMIT by: Date: 9/12/13 OPERATION PERMIT by: APPROVED MAR 11 2014

AUTHORIZATION TO CONSTRUCT by: Date: 9/13/13 Existing System Inspected by: Date:

Health Dept. Copy - WHITE Applicant (Final Approval) - YELLOW Applicant (Conditional Approval) - PINK

JOEL H. PATTERSON III, PLS
LICENSE NUMBER: L-3717

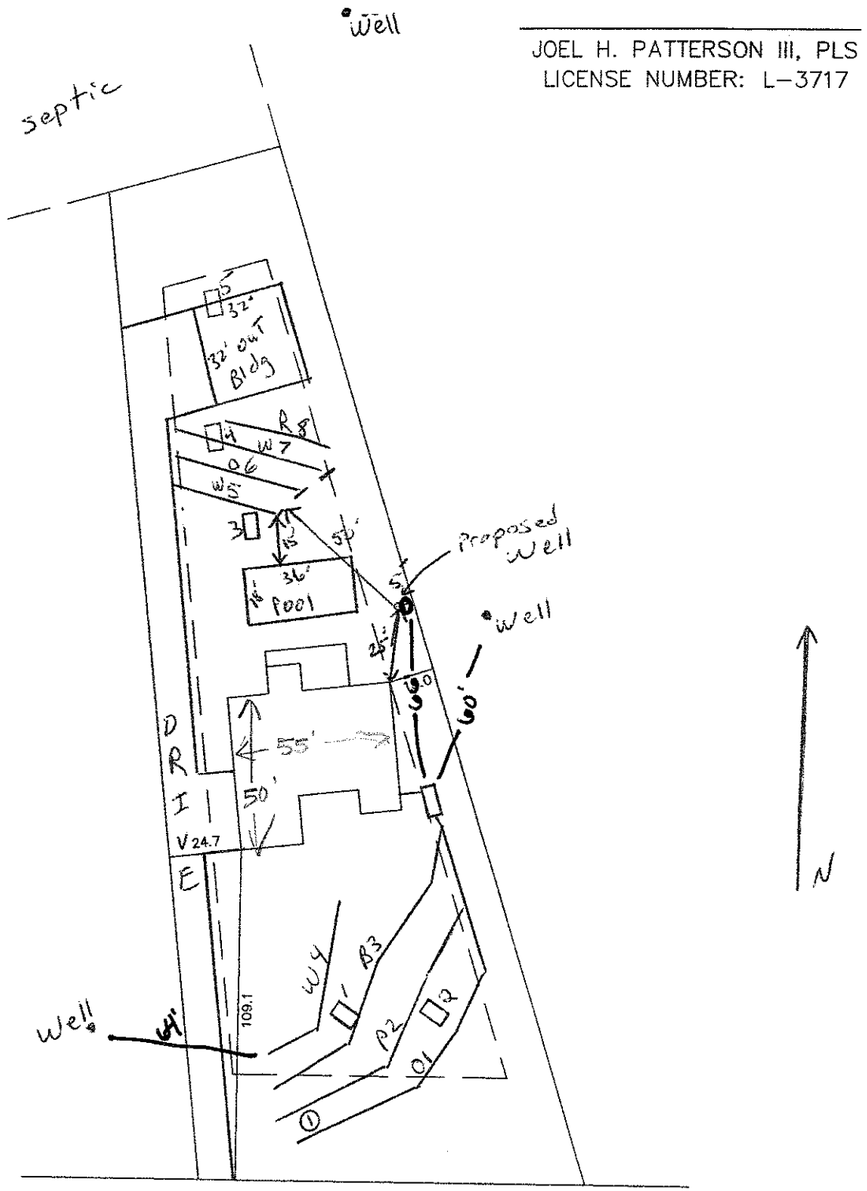

PLOT PLAN SURVEY

OF

Lot 94 "SHAVENDERS BLUFF" Phase Two, Section B

SCALE 1" = 50'

Davidson Twsp., Iredell Co., NC

ACQUIRED BY: Shaw Custom Builders

FIELD BOOK:
FILE: 13074
TAX MAP NO: