2:30

IREDELL COUNTY HEALTH DEPARTMENT

STATESVILLE 704-878-5305 MOORESVILLE 704-664-5281

IMPROVEMENT PERMIT / AUTHORIZATION TO CONSTRUCT / OPERATION PERMIT / EXISTING SYSTEM INSPECTION

PERMIT# 070870 PIN# 4627926470 DATE 2/4/98

OWNER OR CONTRACTOR SHAVENDER'S DEV. PHONE: Business 663-6905 T JACOBS Home

ADDRESS 1143-D EXECUTIVE CIRCLE - CARY NC 27511

LOCATION BRAWLEY SCHOOL - TR BLUME - TL BEATEN PATH - TL DOBBEN CT - CORNER OF DOBBEN

SUBDIVISION SHAVENDER'S BLUFF BLOCK / SECTION LOT 24 LOT AREA .754C SITE CLASS. PS DESIGN FLOW 480 GPD L.T.A.R. .3080 MA

Septic Tank: 1000 Gallons; STB 744 Date 4/6/98
Pump Tank: Gallons; PT Date
Pump Make: Model Serial No.
Nitrification Field: No Fields 1 Square Feet 1200 Linear Feet 400
No Lines 4@100 Trench Width 36" Max Trench Bottom Depth 36" Gravel Depth 12"

☑ New System ☐ Repair System Type: I, II, III, IV, V, VI
System Description: GRAVITY CONVENTIONAL
Repair System Description: PUMP SAME
Maintenance Agreement Required: ☐ Yes ☑ No

☑ House/Mod. Home No. Bedrooms 3
☐ Mobile Home No. Bathrooms 2
☐ Business No. Employees
☐ Other


☐ Slab ☑ Crawl Space ☐ Basement w/plumbing ☐ Basement wo/plumbing

Water Supply: ☑ Individual ☐ Public ☐ Community

Comments:/Conditions:

Comments:/Conditions:

INITIAL SITE SKETCH

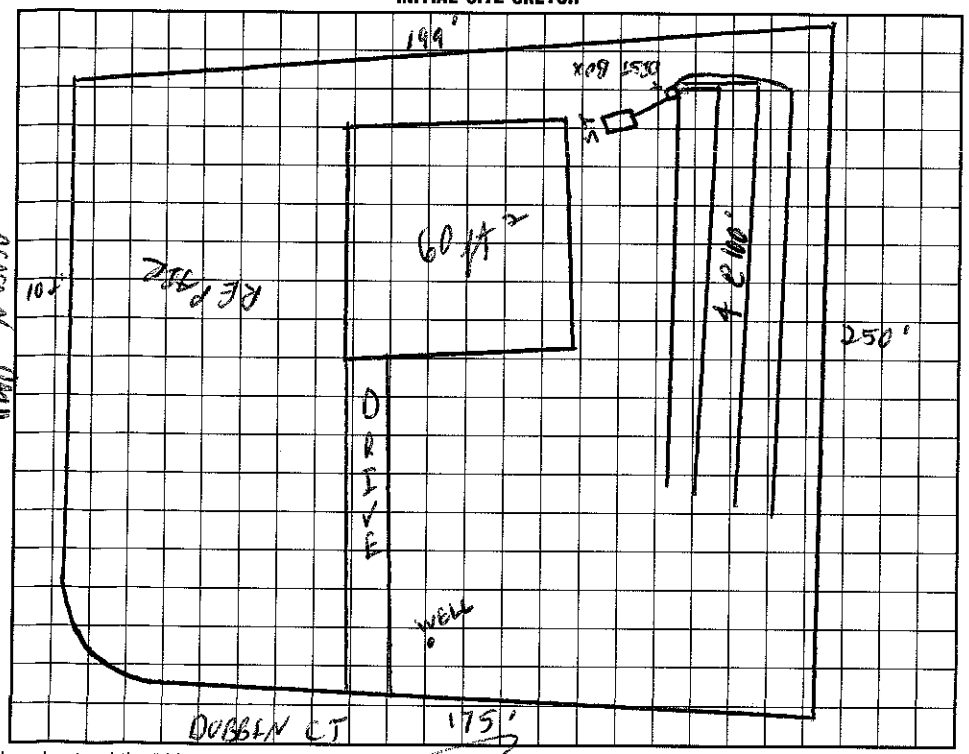

AS BUILT SKETCH

I understand that this permit can be suspended or revoked if any false information is supplied toward securing the permit/any unauthorized changes are made to the site/any unauthorized changes are made in the installation of the system. Improvement Permit with plat valid without expiration. Improvement Permit with site plan valid for sixty months. Authorization to Construct is valid for a period equal to that of Improvement Permit – not to exceed sixty months.

Signed: date 2/5/98

Improvement Permit by: C. RS date 2/4/98

Authorization to Construct by: C. RS date 2/4/98

Installed by: LARRY BEAM

Operation Permit by: C. date 6/2/98

Existing System Inspection by: date

HEALTH DEPT. COPY: WHITE INSPECTION COPY (FINAL): GREEN OWNER COPY (FINAL): YELLOW INSPECTION COPY (INITIAL): PINK OWNER COPY (INITIAL): GOLD