IREDELL COUNTY HEALTH DEPARTMENT

STATESVILLE 704-878-5305 MOORESVILLE 704-664-5281

IMPROVEMENT PERMIT / AUTHORIZATION TO CONSTRUCT / OPERATION PERMIT / EXISTING SYSTEM INSPECTION

PERMIT# 070864 PIN# 462792662 2 DATE 12/9/98

OWNER OR CONTRACTOR SHAVENDER'S DEV CO. PHONE: Business 663-6405 T JACOBS Home

ADDRESS 1143-D EXECUTIVE CIRCLE - CARY NC 27511

LOCATION BRAWLEY SCHOOL RD - TR BLUME - TL BEAVEN PATH - CORNER OF DOBBEN CT

SUBDIVISION SHAVENDERS BLUFF BLOCK / SECTION LOT 25 LOT AREA .75AC SITE CLASS. RS DESIGN FLOW 360 GPD L.T.A.R. .350 GPD/FT²

Septic Tank: 1000 Gallons; STB 774 Date 9/11/98

Pump Tank: Gallons; PT Date

Pump Make: Model Serial No.

Nitrification Field: No Fields Square Feet Linear Feet

No Lines Trench Width Max Trench Bottom Depth Gravel Depth

☑ New System ☐ Repair System Type: I, II, (III), IV, V, VI

System Description: GRAVITY CHAMBERS OR ADS

Repair System Description: SAME

Maintenance Agreement Required: ☐ Yes ☑ No

☑ House/Mod. Home No. Bedrooms 3

☐ Mobile Home No. Bathrooms 3

☐ Business No. Employees

☐ Other


☐ Slab ☑ Crawl Space ☐ Basement w/plumbing ☐ Basement wo/plumbing

Water Supply: ☑ Individual ☐ Public ☐ Community

Comments:/Conditions:

Comments:/Conditions:

INITIAL SITE SKETCH

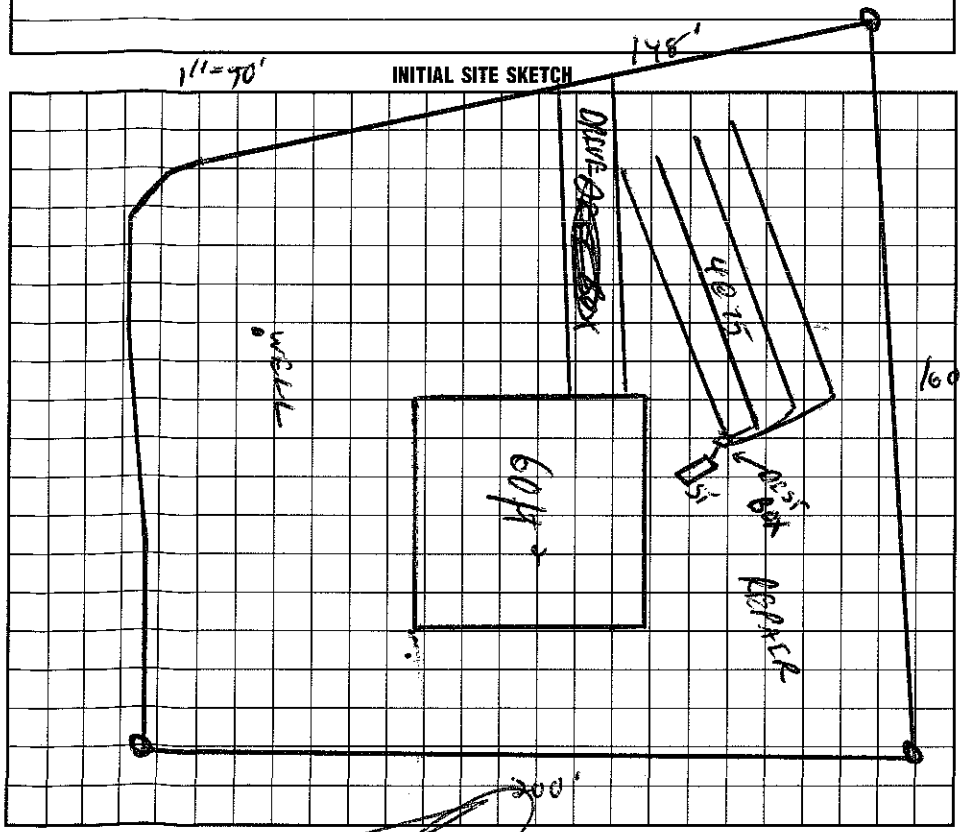

AS BUILT SKETCH

I understand that this permit can be suspended or revoked if any false information is supplied toward securing the permit/any unauthorized changes are made to the site/any unauthorized changes are made in the installation of the system. Improvement Permit with plat valid without expiration. Improvement Permit with site plan valid for sixty months. Authorization to Construct is valid for a period equal to that of Improvement Permit – not to exceed sixty months.

Signed: date 12/11/98

Improvement Permit by: C. B. CS date 12/4/98

Authorization to Construct by: C. B. CS date 12/9/98

Installed by: LARRY BEAM

Operation Permit by: C. B. CS date 12/15/98

Existing System Inspection by: date

HEALTH DEPT. COPY: WHITE INSPECTION COPY (FINAL): GREEN OWNER COPY (FINAL): YELLOW INSPECTION COPY (INITIAL): PINK OWNER COPY (INITIAL): GOLD