IREDELL COUNTY HEALTH DEPARTMENT

→ Authorization to Construct

STATESVILLE 704-878-5305 MOORESVILLE 704-664-5281

IMPROVEMENT PERMIT / CERTIFICATE OF COMPLETION / OPERATION PERMIT / EXISTING SYSTEM INSPECTION

PROPERTY DESCRIPTION NO. 23967 DATE 7/2/96 TAX MAP NO. 2L-4-13 pt of 4627926728 Watershed: ☑ Yes ☐ No

OWNER OR CONTRACTOR James Micale PHONE: Business _____ Home _____ WSIV CA

ADDRESS 21228 Nantahala Blvd Cornelius NC 28031

LOCATION Brawley School - TR Blumenthal - TL Beaton Rd. lot on left

SUBDIVISION Simonds Bluff BLOCK / SECTION 1 LOT 26 LOT AREA .7365 ac SITE CLASS. PS DESIGN FLOW 480 gpd L.T.A.R. .3 gpd/ft²

Septic Tank: 1000 Gallons; STB 724 Date 8/1/96

Pump Tank: _____ Gallons; PT 27 Date 9/21/96

Pump Make: LIBERTY Model .5 HP Serial No. _____

Nitrification Field: No Fields 1 Square Feet 900 Linear Feet 900

No Lines 6 Trench Width 36" Max Trench Bottom Depth 36" Gravel Depth N/A

☑ New System ☐ Repair System Type: I, II, III, IV, V, VI

System Description: Pump chamber

Repair System Description: Pump Panel

Maintenance Agreement Required: ☐ Yes ☑ No

☑ House/Mod. Home No. Bedrooms 4

☐ Mobile Home No. Bathrooms 2.5

☐ Business No. Employees _____

☐ Other _____


☐ Slab ☑ Crawl Space ☐ Basement w/plumbing ☐ Basement wo/plumbing

Water Supply: ☑ Individual ☐ Community ☐ Public

Comments: Drainage Area to be properly filed before Operations Permit can be issued.

Comments: LINES, TANKS, PRESSURE CHECKED 10/28/96 CBP

INITIAL SITE SKETCH

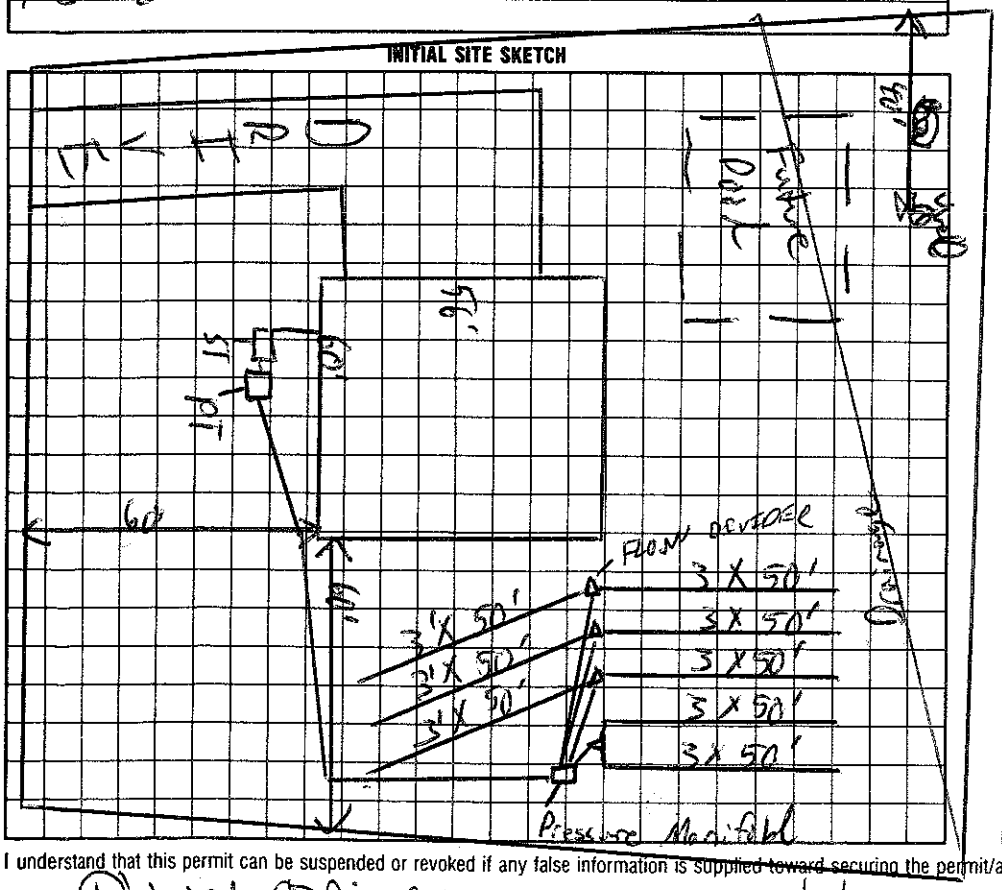

AS BUILT SKETCH

I understand that this permit can be suspended or revoked if any false information is supplied toward securing the permit/any unauthorized changes are made to the site/any unauthorized changes are made in the installation of the system.

Signed: Deborah C Micale 7/5/96 Installed by: CHRISTENBERY

Improvement Permit by: C. Rob Tyson EHSI date 7/2/96 Certificate of Completion by: _____ date _____

Existing System Inspection by: C. Rob Tyson EHSI date 7/2/96 Operation Permit by: Wesley Sparks RS date 11/25/96

HEALTH DEPT. COPY: WHITE INSPECTION COPY (FINAL): GREEN OWNER COPY (FINAL): YELLOW INSPECTION COPY (INITIAL): PINK OWNER COPY (INITIAL): GOLD