IREDELL COUNTY HEALTH DEPARTMENT

STATESVILLE 704-878-5305 MOORESVILLE 704-664-5281

IMPROVEMENT PERMIT / ~~CERTIFICATE OF COMPLETION~~ / OPERATION PERMIT / EXISTING SYSTEM INSPECTION

Authorization to Construct

4627926934

PROPERTY DESCRIPTION NO. 23809 DATE 6/25/96 TAX MAP NO. pt of 4-L-A-13 Watershed: ☑ Yes ☐ No

OWNER OR CONTRACTOR ~~Rumsey Creek~~ Payton Tucker PHONE: Business 892-0451 Home

ADDRESS 2031 Deep Cove Ct Cornelius NC 28031

LOCATION Barley School Rd - TR Blume Rd - TL Beaton Path - Lot on left ≈ 0.5 miles

SUBDIVISION Shaver's Bluff BLOCK / SECTION LOT 27 LOT AREA SITE CLASS. PS DESIGN FLOW 360gpd L.T.A.R. 3 gpd/ft²

Septic Tank: 1000 Gallons; STB 794 Date 6/25/96

Pump Tank: Gallons; PT Date

Pump Make: Model Serial No.

Nitrification Field: No Fields 1 Square Feet ~~720~~ 900 Linear Feet ~~480~~ 300

No Lines 4 Trench Width 36" Max Trench Bottom Depth 36" Gravel Depth 12"

☑ New System ☐ Repair System Type: Conventional ~~Low Pressure Pipe~~ CHAMBERED

System Description: Gravity

Repair System Description: Rock Panels

Maintenance Agreement Required: ☐ Yes ☒ No

☑ House/Mod. Home No. Bedrooms 3

☐ Mobile Home No. Bathrooms 2

☐ Business No. Employees

☐ Other

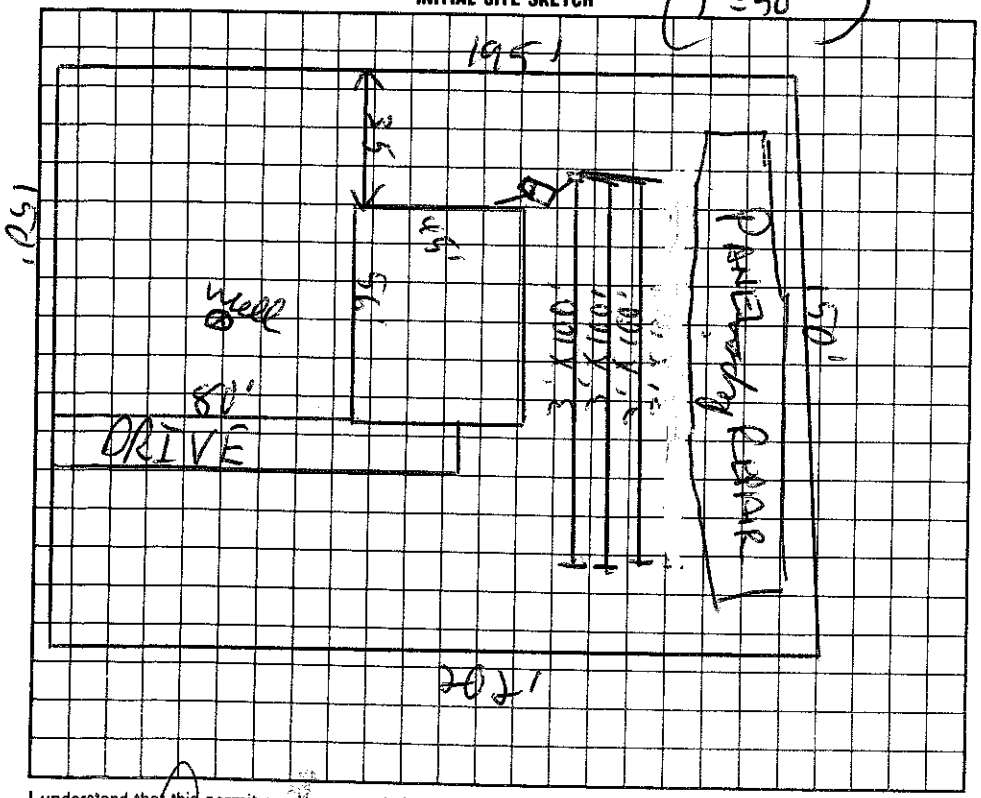
☐ Slab ☑ Crawl Space ☐ Basement w/plumbing ☐ Basement wo/plumbing

Water Supply: ☑ Individual ☐ Community ☐ Public

Comments:

Comments:

INITIAL SITE SKETCH (1"=50')


195'
50'
80'
55'
95'
Well
80'
DRIVE
Proposed Repair Area
100'
100'
100'