IREDELL COUNTY HEALTH DEPARTMENT

AUTHORIZATION TO CONSTRUCT

STATESVILLE 704-878-5305 MOORESVILLE 704-664-5281

IMPROVEMENT PERMIT / ~~CERTIFICATE OF COMPLETION~~ / OPERATION PERMIT / EXISTING SYSTEM INSPECT

PROPERTY DESCRIPTION NO. 24202 DATE 6/13/97 TAX MAP NO. 2L-A-13

OWNER OR CONTRACTOR TIM PERRY PHONE: Business 4627927079 Home ~~[illegible]~~ 7374 662-0290 Watershed: ☑ Yes ☐

ADDRESS 218 DOOLIE RD MOORESVILLE NC 28115

LOCATION BRAWLEY SCHOOL RD - ~~[illegible]~~ - TR BLUME - TL BEATEN PATH - 2ND LOT ON LEFT AFTER FOREST COVE

SUBDIVISION SHAVENDER'S BLUFF BLOCK / SECTION ____ LOT 22 LOT AREA .77 AC SITE CLASS. PS DESIGN FLOW 480 GPD L.T.A.R. .360/FT²

Septic Tank: 1000 Gallons; STB 794 Date 4/2/97

Pump Tank: ____ Gallons; PT ____ Date ____

Pump Make: ____ Model ____ Serial No. ____

Nitrification Field: No Fields 1 Square Feet 1200 Linear Feet 400

No Lines 6 Trench Width 36" Max Trench Bottom Depth 36" Gravel Depth N/A

☑ New System ☐ Repair System Type: I, II, (III) IV, V, VI

System Description: GRAVITY CHAMBERED

Repair System Description: GRAVITY PANEL

Maintenance Agreement Required: ☐ Yes ☑ No

☑ House/Mod. Home No. Bedrooms 4

☐ Mobile Home No. Bathrooms 4

☐ Business No. Employees ____

☐ Other ____


☐ Slab ☑ Crawl Space ☐ Basement w/plumbing ☐ Basement wo/plumbing

Water Supply: ☑ Individual ☐ Community ☐ Public

Comments:

Comments: ~~[illegible]~~ installed as shown -

INITIAL SITE SKETCH 1" = 50'

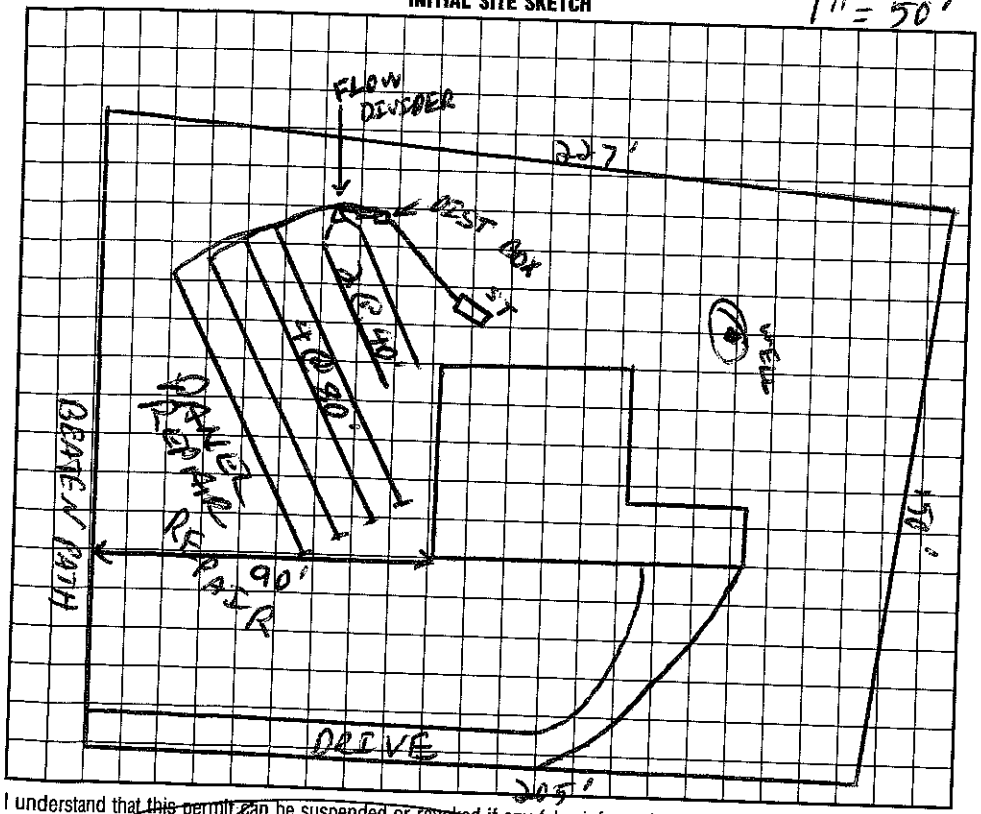

AS BUILT SKETCH

I understand that ~~this permit~~ can be suspended or ~~revoked~~ if any false information is supplied toward securing the permit/any unauthorized changes are made to the site/any unauthorized changes are made in the installation of the system. Improvement Permit is valid for 60 months from date of issuance.

Signed: ____

Improvement Permit by: C. Blythe date 6/13/97

AUTHORIZATION TO CONSTRUCT Existing System Inspection by: C. Blythe date 6/13/97

Installed by: F.I. Erwin

Certificate of Completion by: Wesley Sparks date 6/19/97

Operation Permit by: Wesley Sparks date 6/19/97

HEALTH DEPT. COPY: WHITE INSPECTION COPY (FINAL): GREEN OWNER COPY (FINAL): YELLOW INSPECTION COPY (INITIAL): PINK OWNER COPY (INITIAL): GOLD