IREDELL COUNTY HEALTH DEPARTMENT

Authorization to Construct 4627927224

STATESVILLE 704-878-5305 MOORESVILLE 704-664-5281

IMPROVEMENT PERMIT / ~~CERTIFICATE OF COMPLETION~~ / OPERATION PERMIT / EXISTING SYSTEM INSPECTION

PROPERTY DESCRIPTION NO. 25703 DATE 1/4/97 TAX MAP NO. 2LA 13 Watershed: [X] Yes [ ] No

OWNER OR CONTRACTOR Otto A Butenson PHONE: Business _____ Home 663-4767

ADDRESS 175 Hoyelton Lp. Mooresville, NC. 28115

LOCATION 1100 TR Bluewater Tr Beaten Path on (L)

SUBDIVISION Shoreline Bluff BLOCK / SECTION _____ LOT 23 LOT AREA .75 AC SITE CLASS. PS. DESIGN FLOW 480 L.T.A.R. .3

Septic Tank: 1000 Gallons; STB 794 Date 2/26/97

Pump Tank: _____ Gallons; PT _____ Date _____

Pump Make: _____ Model _____ Serial No. _____

Nitrification Field: No Fields 1 Square Feet 1600 Linear Feet 535

No Lines 5 Trench Width 36" Max Trench Bottom Depth 36" Gravel Depth 12"

[X] New System [ ] Repair System Type: I, II, III, IV, V, VI

System Description: CONV - DIST BOX

Repair System Description: 16" PPBS - PRESSURE

Maintenance Agreement Required: [ ] Yes [X] No

[X] House/Mod. Home No. Bedrooms 4

[ ] Mobile Home No. Bathrooms 2.5

[ ] Business No. Employees _____

[ ] Other _____


[ ] Slab [X] Crawl Space [ ] Basement w/plumbing [ ] Basement wo/plumbing

Water Supply: [X] Individual [ ] Community [ ] Public

Comments:

Comments:

INITIAL SITE SKETCH

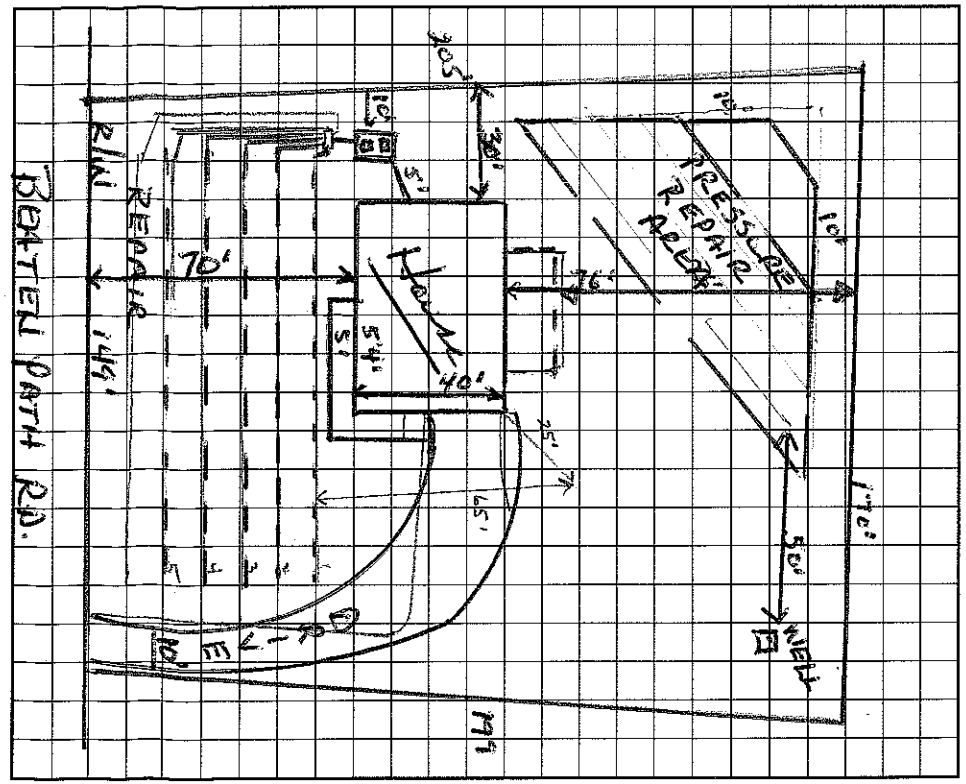

AS BUILT SKETCH

I understand that this permit can be suspended or revoked if any false information is supplied toward securing the permit/any unauthorized changes are made to the site/any unauthorized changes are made in the installation of the system.

Signed: [signature]

Improvement Permit by: Wesley Sparks RS. date 1/6/97

~~Existing System Inspection~~ Authorization by: Wesley Sparks RS. date 1/6/97

Installed by: Willie Christenbury

Certificate of Completion by: Wesley Sparks RS. date 5/20/97

Operation Permit by: Wesley Sparks RS. date 5/20/97

HEALTH DEPT. COPY: WHITE INSPECTION COPY (FINAL): GREEN OWNER COPY (FINAL): YELLOW INSPECTION COPY (INITIAL): PINK OWNER COPY (INITIAL): GOLD