# IREDELL COUNTY HEALTH DEPARTMENT

STATESVILLE 704-878-5305 MOORESVILLE 704-664-5281

## IMPROVEMENT PERMIT / AUTHORIZATION TO CONSTRUCT / OPERATION PERMIT / EXISTING SYSTEM INSPECTION

PERMIT# 088016 PIN# ~~4627-92-9474~~ 4627929467 DATE 3/30/00

OWNER OR CONTRACTOR Chris Borst PHONE: Business 662-2045 Home

ADDRESS PO Box 327 Terrell, NC. 28682

LOCATION 1100 TR B Dume Rd. Tr Beaten Path. on (R) before Christy Lane

SUBDIVISION SHAY BLUFF BLOCK / SECTION 1 LOT 7 LOT AREA ~1.62 Ac SITE CLASS. RS DESIGN FLOW 480 L.T.A.R. .3

Septic Tank: 1000 Gallons; STB 312 Date 11/20/00

Pump Tank: Gallons; PT Date

Pump Make: Model Serial No.

Nitrification Field: No Fields 1 Square Feet 1200 Linear Feet 400

No Lines @ 5 Trench Width 36" Max Trench Bottom Depth 36" Gravel Depth N/A

[X] New System [ ] Repair System Type: I, II, (III), IV, V, VI

System Description: HDS Deep Loading Contour Line

Repair System Description: Pressure HDS

Maintenance Agreement Required: [ ] Yes [X] No

[X] House/Mod. Home No. Bedrooms 4

[ ] Mobile Home No. Bathrooms 2.5

[ ] Business No. Employees

[ ] Other


[ ] Slab [ ] Crawl Space [X] Basement w/plumbing [ ] Basement wo/plumbing

Water Supply: [X] Individual [ ] Public [ ] Community

Comments:/Conditions:

Comments:/Conditions:

INITIAL SITE SKETCH (1"=60')

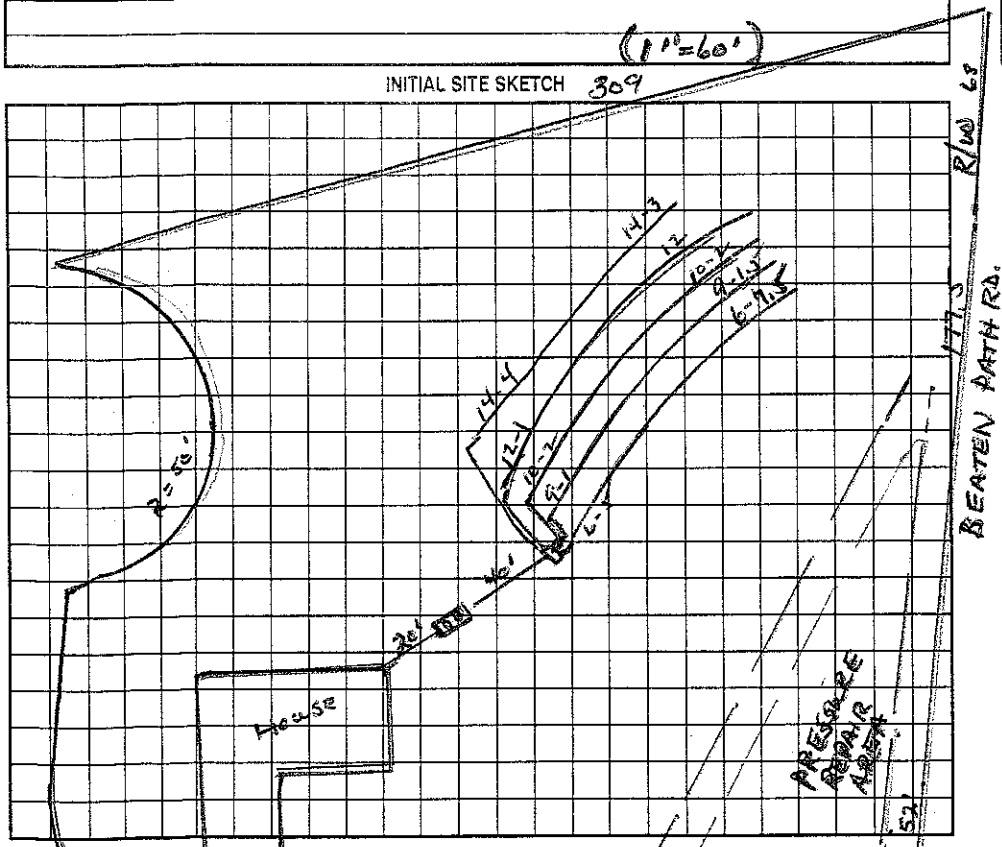


AS BUILT SKETCH

Permit can be suspended or revoked if any false information is supplied toward securing the permit/any unauthorized changes are made to the site/any unauthorized changes are made in the installation of the system. Improvement Permit with plat valid without expiration. Improvement Permit with site plan valid for sixty months. Authorization to Construct is valid for a period equal to that of Improvement Permit – not to exceed sixty months.

Signed: [signature] date 4/3/00 Installed by: MacLeod Const.

Improvement Permit by: Wesley Sparks 218 RS. CHRISTY LANE date 3/30/00

Authorization to Construct by: Wesley Sparks RS. date 3/30/00

Operation Permit by: Wesley Sparks RS. date 2/2/01

Existing System Inspection by: date

HEALTH DEPT. COPY: WHITE OWNER COPY (FINAL): YELLOW OWNER COPY (INITIAL): PINK