IREDELL COUNTY HEALTH DEPARTMENT

STATESVILLE 704-878-5305 $550.00 Paid MOORESVILLE 704-664-5281

IMPROVEMENT PERMIT / AUTHORIZATION TO CONSTRUCT / OPERATION PERMIT / EXISTING SYSTEM INSPECTION

PERMIT# 137050 PIN# 4627929980

OWNER OR APPLICANT Joseph B Talton DATE 9-22-06

ADDRESS P.O. Box 5482 Mooresville, NC 28117 PHONE: Business 309-1820 Home 704 799-7036

LOCATION Brawley School Rd TR Blume TL Beaten Path on right past Christy Ln next to #312

SUBDIVISION Clay BLOCK / SECTION 9 LOT 105 LOT AREA .69 Acre SITE CLASS PS DESIGN FLOW BioDigest T.A.R. .3 to .4

Septic Tank: 1000 Gallons: STB 744 Date 9-3-06
Pump Tank: 1000 Gallons: PT 27 Date 9-10-06
Pump Make Gould Model WE05111H Serial No. S6540630
Nitrification Field: No. Fields 1 Square Feet 400 Linear Feet 200
No. Lines 4 5 Trench Width min. 24" Max Trench Bottom Depth 46"

[X] New System [ ] Repair [ ] Expansion System Type: I II (III) IV V VI
System Description: EP - Panel Block (Pumped)
Repair System Description: Same
Maintenance Agreement Required: [ ] Yes [X] No
Gravel Depth N/A [ ] Gravity [X] Pressure


[X] House/Mod. Home No. Bedrooms 3
[ ] Mobile Home No. Persons
[ ] Business No. Employees
[ ] Other

Water Supply: [X] Individual [ ] Public [ ] Community

[ ] Slab [ ] Crawl Space [X] Basement w/plumbing [ ] Basement wo/plumbing


Comments:/Conditions: Must keep well at least 50ft from Septic System. Keep tanks & drainfield at least 10ft from PL (Supply line 5ft from PL) Keep Drainfield 25ft from basement wall

INITIAL SITE SKETCH

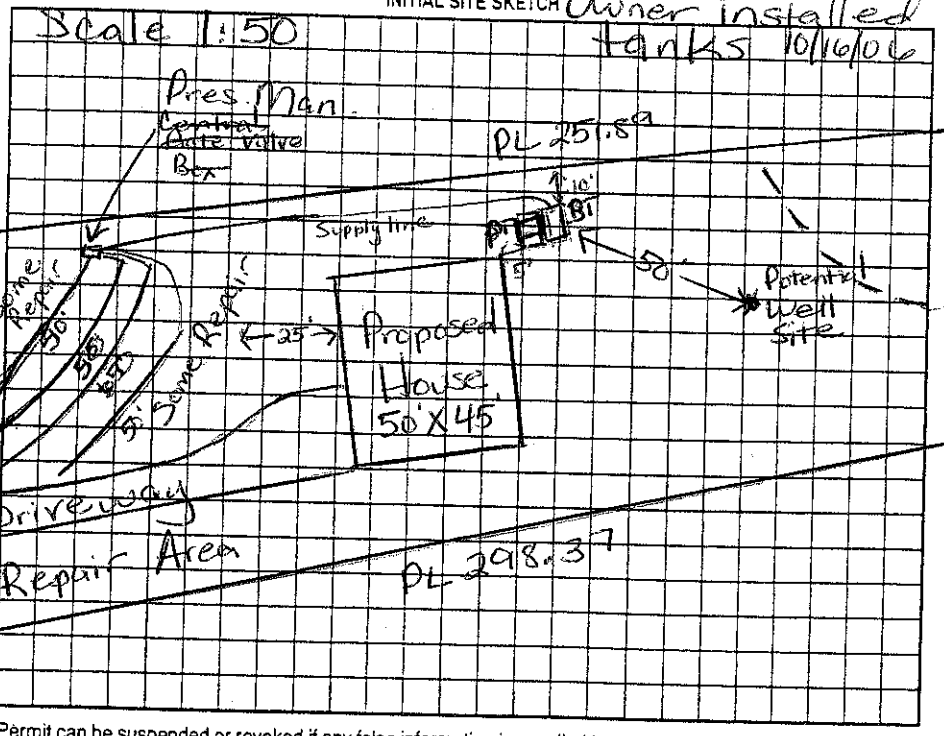

Comments:/Conditions: Do Not Cross drainfield with driveway. Use a total of 46 panels, ~~drilled 3/16" hole~~ Measured 54ft to well 10/16/06 mjs

AS BUILT SKETCH

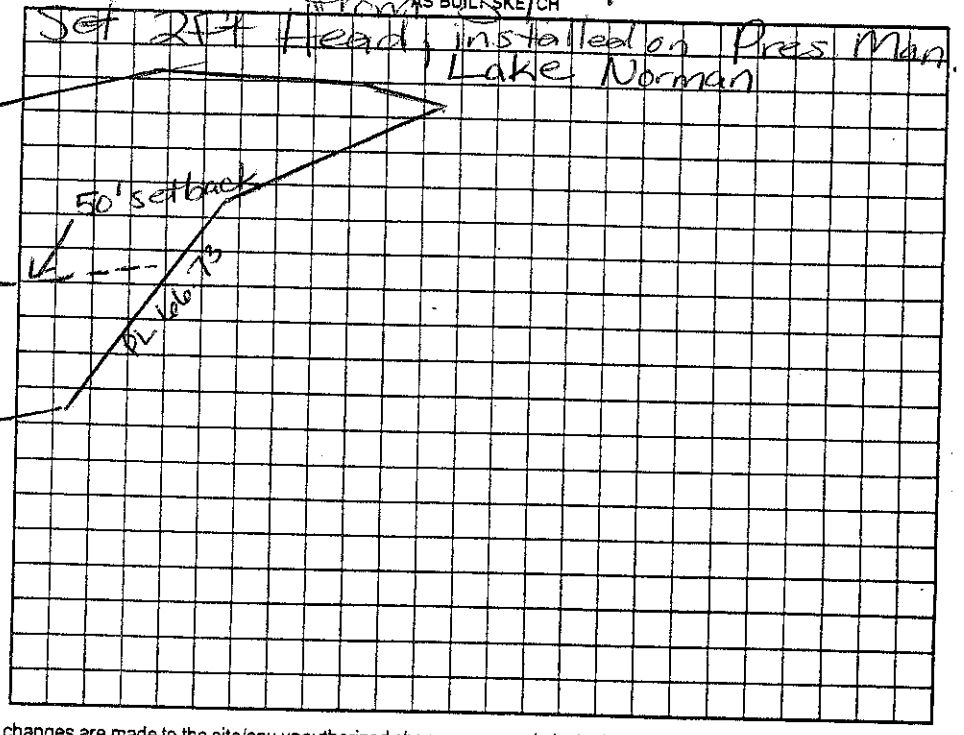

Permit can be suspended or revoked if any false information is supplied toward securing the permit/any unauthorized changes are made to the site/any unauthorized changes are made in the installation of the system. Improvement Permit with plat valid without expiration. [ ] Improvement Permit with site plan valid for sixty months [ ] Authorization to Construct is valid for a period equal to that of Improvement Permit – not to exceed sixty months.

Signed: Joseph Talton date 9/22/06 Installed by: E J Ervin

Improvement Permit by: Maria H Dolson RS date 9/22/06 Operation Permit by: _____ RS date _____

Authorization to Construct by: Maria H Dolson RS date 9/22/06 Existing System Inspection by: Maria H Dolson RS date 4/30/07

HEALTH DEPT. COPY: WHITE OWNER COPY (FINAL): YELLOW OWNER COPY (INITIAL): PINK