IREDELL COUNTY HEALTH DEPARTMENT

STATESVILLE 704-878-5305 MOORESVILLE 704-664-5281

IMPROVEMENT PERMIT / AUTHORIZATION TO CONSTRUCT / OPERATION PERMIT / EXISTING SYSTEM INSPECTION

PERMIT# 067755 PIN# 4627 91 2791 4627 93 0221 DATE 8/17/98

OWNER OR CONTRACTOR Kevin Huffstetler PHONE: Business 613-5780 Home

ADDRESS 4612 Charlie Hoey Rd. Charlotte, NC 28214

LOCATION 1100 TR Blume Rd. to Beaton Path Tr. Dobbin Ct., 8th lot on left

SUBDIVISION Shoreshores Bluff BLOCK / SECTION LOT 149 LOT AREA .98Ac SITE CLASS. PS DESIGN FLOW 480 L.T.A.R. .3

Septic Tank: 1000 Gallons; STB 794 Date

Pump Tank: 1000 Gallons; PT 37 Date

Pump Make: Gould's Model WE0-311M Serial No. M9846766

Nitrification Field: No Fields 1 Square Feet 1200 Linear Feet 400

No Lines 3@133'x3' Trench Width 36" Max Trench Bottom Depth 36" Gravel Depth N/A

[X] New System [ ] Repair System Type: I, II, III, IV, V, VI.

System Description: Pump - Pan + ~~Plastic~~

Repair System Description: SAME HOS

Maintenance Agreement Required: [ ] Yes [X] No

[X] House/Mod. Home No. Bedrooms 4

[ ] Mobile Home No. Bathrooms 4

[ ] Business No. Employees

[ ] Other


[ ] Slab [X] Crawl Space [ ] Basement w/plumbing [ ] Basement wo/plumbing

Water Supply: [X] Individual [ ] Public [ ] Community


Comments:/Conditions:

Comments:/Conditions:

INITIAL SITE SKETCH

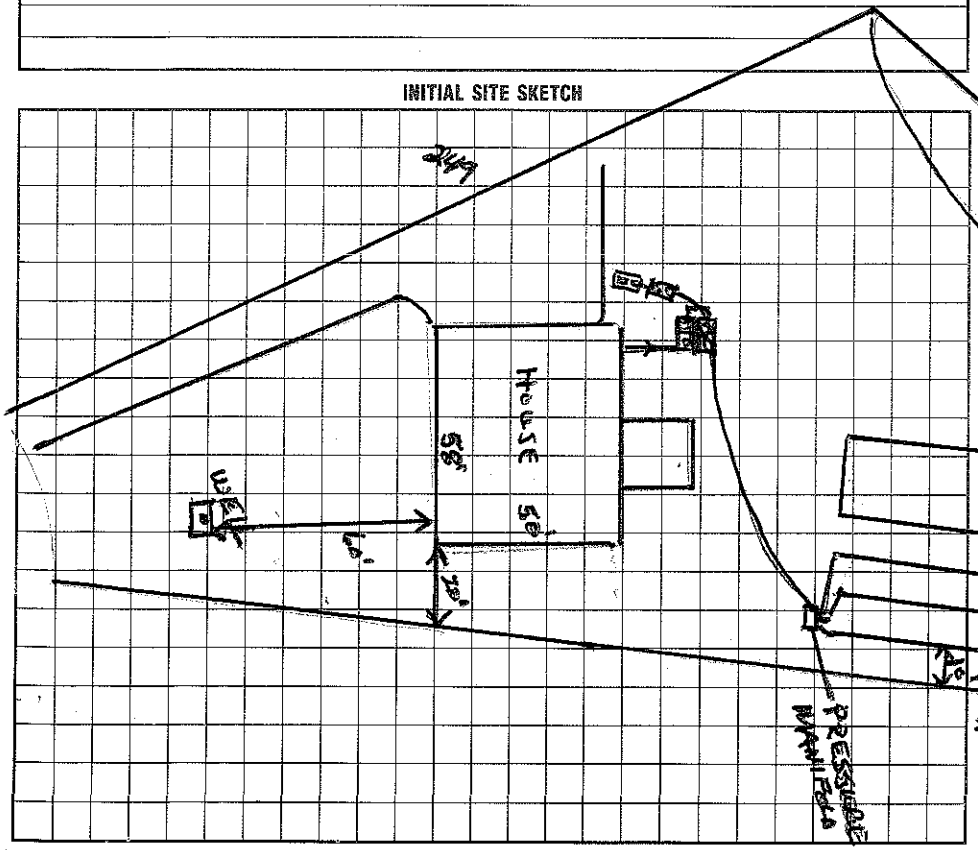

AS BUILT SKETCH

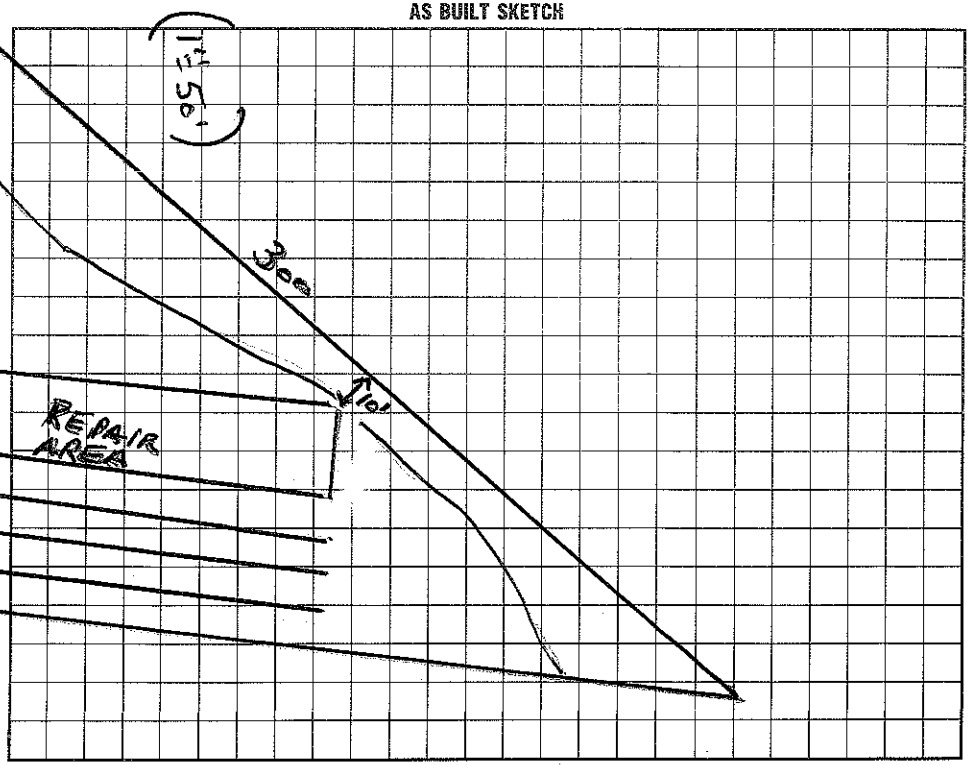

I understand that this permit can be suspended or revoked if any false information is supplied toward securing the permit/any unauthorized changes are made to the site/any unauthorized changes are made in the installation of the system. Improvement Permit with plat valid without expiration. Improvement Permit with site plan valid for sixty months. Authorization to Construct is valid for a period equal to that of Improvement Permit – not to exceed sixty months.

Signed: * date 8/19/98 Installed by: Bob McCarver

Improvement Permit by: Wesley Sparks R.S. date 8/17/98 Operation Permit by: Wesley Sparks R.S. date 4/26/99

Authorization to Construct by: Wesley Sparks R.S. date 8/17/98 Existing System Inspection by: date

HEALTH DEPT. COPY: WHITE INSPECTION COPY (FINAL): GREEN OWNER COPY (FINAL): YELLOW INSPECTION COPY (INITIAL): PINK OWNER COPY (INITIAL): GOLD