IREDELL COUNTY HEALTH DEPARTMENT

AUTHORIZATION TO CONSTRUCT 4627930566

STATESVILLE 704-878-5305 MOORESVILLE 704-664-5281

IMPROVEMENT PERMIT / ~~CERTIFICATE OF COMPLETION~~ / OPERATION PERMIT / EXISTING SYSTEM INSPECTION

PROPERTY DESCRIPTION NO. 24195 DATE 8/20/96 TAX MAP NO. 2L-A-13 pt of Watershed: ☑ Yes ☐ No

OWNER OR CONTRACTOR ROBERT RIFFLE PHONE: Business Home 664-6800

ADDRESS 5952 GILBERT DAVIS DR. RANDLEMAN NC 27317

LOCATION BRAWLEY SCHOOL RD - TR BLUME RD - TL BEATEN PATH - 8TH LOT ON LEFT PAST CHRISTY LANE.

SUBDIVISION SHAVEDERS BLUFF BLOCK / SECTION LOT 33 LOT AREA 1.54c SITE CLASS. RS DESIGN FLOW 600GPD L.T.A.R. .36GPD/FT

Septic Tank: ~~1500~~ Gallons; STB 1499 Date 2/13/97

Pump Tank: Gallons; PT Date

Pump Make: Model Serial No.

Nitrification Field: No. Fields 1 Square Feet 1500 Linear Feet 500

No. Lines ~~4~~ 5 Trench Width 36" Max Trench Bottom Depth 36" Gravel Depth N/A

☑ New System ☐ Repair System Type: I, II, III, IV, V, VI

System Description: GRAVITY CHAMBERED

Repair System Description: GRAVITY CHAMBERED

Maintenance Agreement Required: ☐ Yes ☑ No

☑ House/Mod. Home No. Bedrooms 5

☐ Mobile Home No. Bathrooms 3.5

☐ Business No. Employees

☐ Other


☐ Slab ☑ Crawl Space ☐ Basement w/plumbing ☐ Basement wo/plumbing

Water Supply: ☑ Individual ☐ Community ☐ Public

Comments: 4@ 125' x3'

Comments:

INITIAL SITE SKETCH 1"=100'

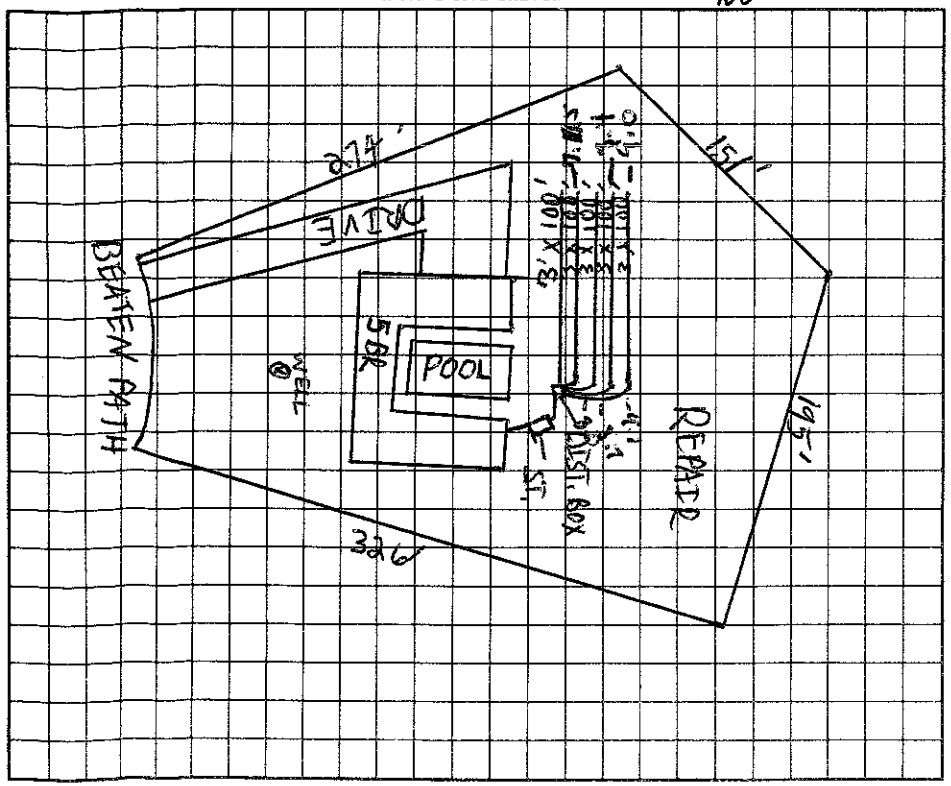

AS BUILT SKETCH

I understand that this permit can be suspended or revoked if any false information is supplied toward securing the permit/any unauthorized changes are made to the site/any unauthorized changes are made in the installation of the system.

Signed: Lucy L. Riffle

Improvement Permit by: C. Ruby Freeman EHSP date 8/20/96

AUTHORIZATION TO CONSTRUCT

~~Existing System Inspection by:~~ C. Ruby Freeman EHSP date 8/20/96

Installed by: Mac Lead contr.

Certificate of Completion by: Wesley Sparks R.S. date 3/21/97

Operation Permit by: Wesley Sparks R.S. date 3/21/97

HEALTH DEPT. COPY: WHITE INSPECTION COPY (FINAL): GREEN OWNER COPY (FINAL): YELLOW INSPECTION COPY (INITIAL): PINK OWNER COPY (INITIAL): GOLD