IREDELL COUNTY HEALTH DEPARTMENT

STATESVILLE 704-878-5305 MOORESVILLE 704-664-5281

IMPROVEMENT PERMIT / CERTIFICATE OF COMPLETION / OPERATION PERMIT / EXISTING SYSTEM INSPECTION

PROPERTY DESCRIPTION NO. 06 7756 DATE 8/5/97 TAX MAP NO. 4627912794 4627-93-1003 Watershed: ☑ Yes ☐ No

OWNER OR CONTRACTOR SHAVENDER'S DEV. (KEVIN + JANELLE NEWELL) PHONE: Business 663-6905 T. JACOBS Home

ADDRESS 143 D EXECUTIVE CIR CARY NC 27511

LOCATION BRAWLEY SCHOOL RD - TR BLUME - TL BEAVER PATH - TL DOBBIN 7TH ON LEFT

SUBDIVISION SHAVENDER'S BLUFF BLOCK / SECTION 2 LOT 150 LOT AREA .94 AC SITE CLASS. PS DESIGN FLOW 450 L.T.A.R. .3

Septic Tank: 1000 Gallons; STB 317 Date 6/2/99

Pump Tank: 1000 Gallons; PT 27 Date 6/7/99

Pump Make: GOULDS Model WE0 311M Serial No. 4120 99

Nitrification Field: No Fields 1 Square Feet 540 Linear Feet 270 *

No Lines 5 Trench Width 24" Max Trench Bottom Depth 36" Gravel Depth N/A

☑ New System ☐ Repair System Type: I, II, III, ⓘ V, VI

System Description: PUMP PANEL

Repair System Description: PUMP PANEL

Maintenance Agreement Required: ☑ Yes ☐ No *

☑ House/Mod. Home No. Bedrooms 4

☐ Mobile Home No. Bathrooms 4

☐ Business No. Employees

☐ Other


☐ Slab ☐ Crawl Space ☑ Basement w/plumbing ☐ Basement wo/plumbing

Water Supply: ☑ Individual ☐ Community ☐ Public


Comments:

Comments:

INITIAL SITE SKETCH

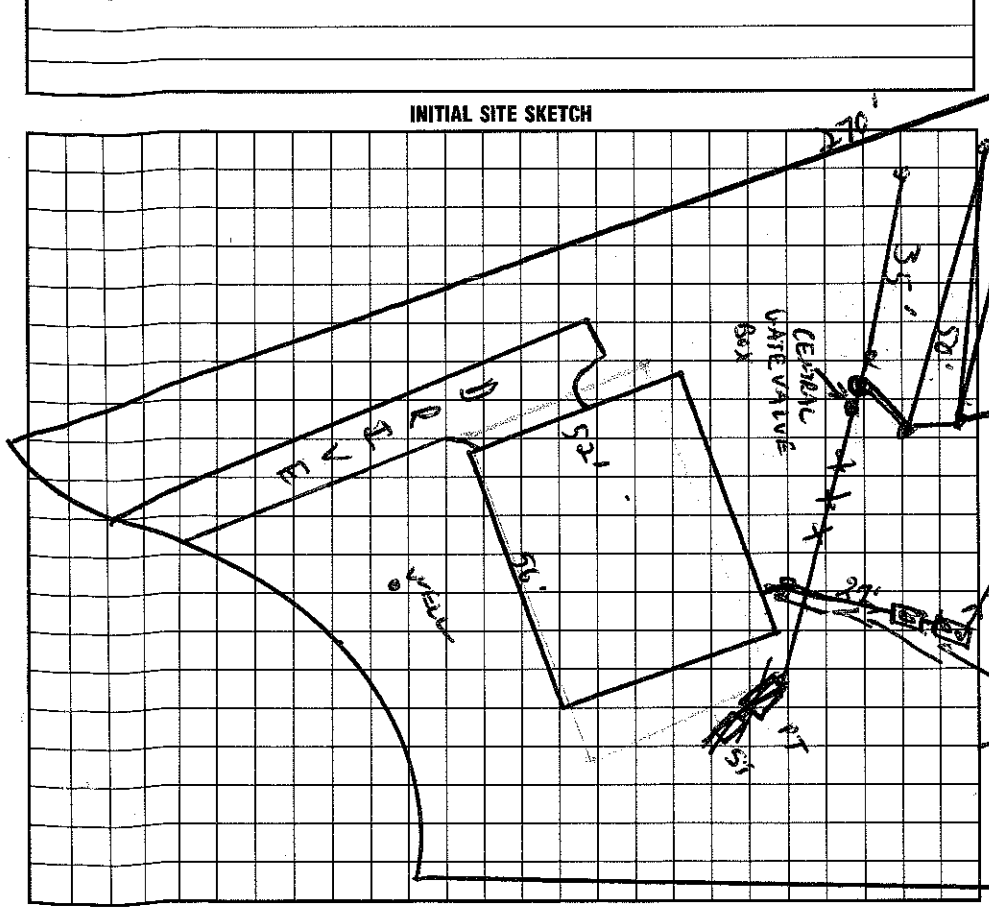

AS BUILT SKETCH

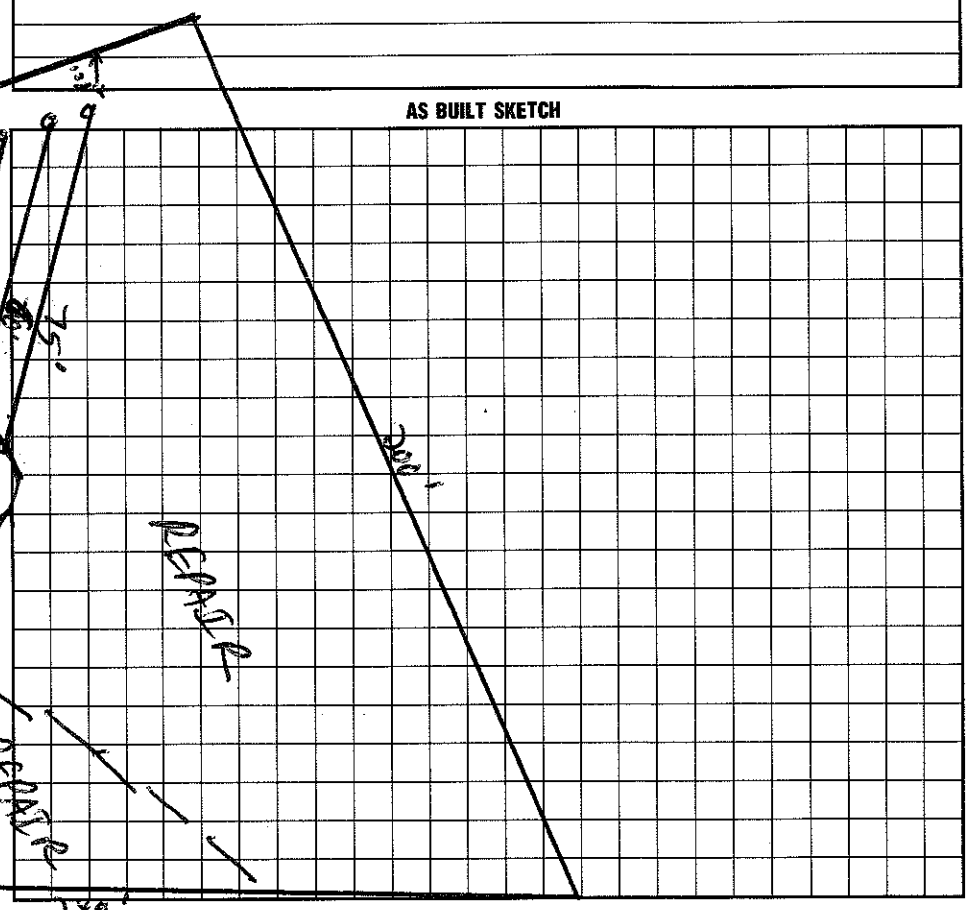

I understand that this permit can be suspended or revoked if any false information is supplied toward securing the permit/any unauthorized changes are made to the site/any unauthorized changes are made in the installation of the system. Improvement Permit is valid for 60 months from date of issuance.

Signed: Leonard Kellum

Improvement Permit by: C. Rogers Freeman date 8/5/97

Existing System Inspection by: C. Rogers Freeman date 1/14/99

Installed by: Bobby McCarver

Certificate of Completion by: Wesley Sparks RS date 8/13/99

Operation Permit by: Wesley Sparks RS date 8/13/99

HEALTH DEPT. COPY: WHITE INSPECTION COPY (FINAL): GREEN OWNER COPY (FINAL): YELLOW INSPECTION COPY (INITIAL): PINK OWNER COPY (INITIAL): GOLD