IREDELL COUNTY HEALTH DEPARTMENT

4627931228

STATESVILLE 704-878-5305 MOORESVILLE 704-664-5281

IMPROVEMENT PERMIT / CERTIFICATE OF COMPLETION / OPERATION PERMIT / EXISTING SYSTEM INSPECTION

PROPERTY DESCRIPTION NO. 06 7754 DATE 7/11/97 TAX MAP NO. 462 7912791

OWNER OR CONTRACTOR SHAVENDER'S DEVELOPMENT PHONE: Business 663-6905 T. JACOBS Home

ADDRESS 1143-D EXECUTIVE CIRCLE CARY NC 27511 Watershed: ☒ Yes ☐ No

LOCATION BRAWLEY SCHOOL RD - TR BLUME - TL BEATEN PATH - TL ORBIT CT - 8TH LOT ON LEFT

SUBDIVISION SHAVENDER'S BLUFF BLOCK / SECTION LOT 148 LOT AREA .94AC SITE CLASS. PS DESIGN FLOW 480GPD L.T.A.R. .36GPD/FT

Septic Tank: 1000 Gallons; STB 1012 Date 4/24/99

Pump Tank: Gallons; PT Date

Pump Make: Model Serial No.

Nitrification Field: No Fields 1 Square Feet 1200 Linear Feet 400

No Lines 4 @100' Trench Width 36" Max Trench Bottom Depth 36" Gravel Depth N/A

☒ New System ☐ Repair System Type: I, II, III, IV, V, VI

System Description: GRAVITY CHAMBERED

Repair System Description: SAME

Maintenance Agreement Required: ☐ Yes ☒ No

☒ House/Mod. Home No. Bedrooms 4

☐ Mobile Home No. Bathrooms 4

☐ Business No. Employees

☐ Other


☐ Slab ☒ Crawl Space ☐ Basement w/plumbing ☐ Basement wo/plumbing

Water Supply: ☒ Individual ☐ Community ☐ Public


Comments:

Comments:

INITIAL SITE SKETCH 1"=50'

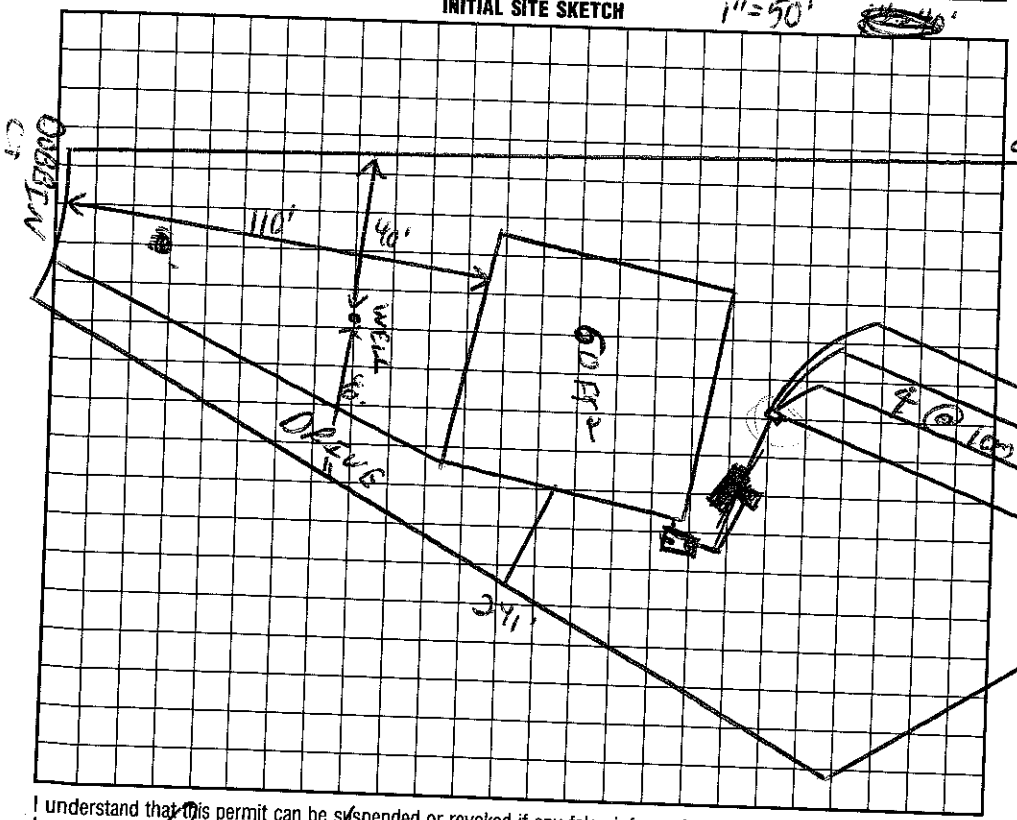

AS BUILT SKETCH

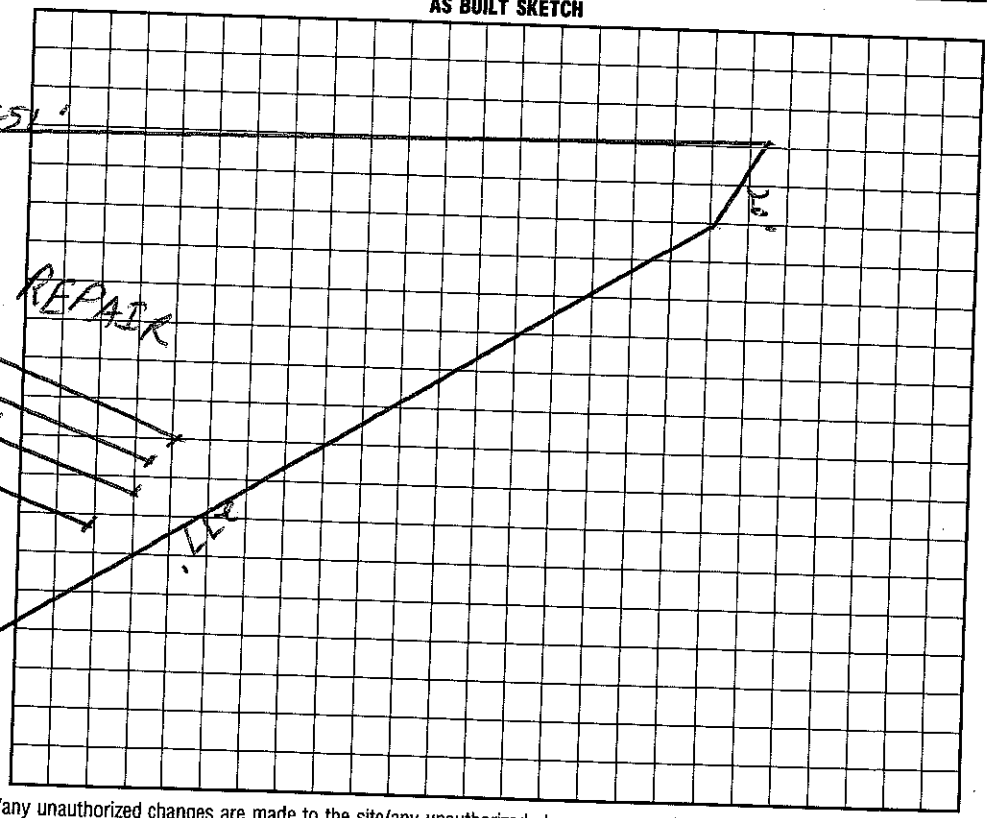

I understand that this permit can be suspended or revoked if any false information is supplied toward securing the permit/any unauthorized changes are made to the site/any unauthorized changes are made in the installation of the system. Improvement Permit is valid for 60 months from date of issuance.

Signed:

Improvement Permit by: date 7/11/97

Existing System Inspection by: date 4/24/99

Installed by: Richard Abernathy

Certificate of Completion by: Wesley Sparks RS date 6/14/99

Operation Permit by: Wesley Sparks RS date 6/14/99

HEALTH DEPT. COPY: WHITE INSPECTION COPY (FINAL): GREEN OWNER COPY (FINAL): YELLOW INSPECTION COPY (INITIAL): PINK OWNER COPY (INITIAL): GOLD