IREDELL COUNTY HEALTH DEPARTMENT

AUTHORIZATION TO CONSTRUCT

(3.00)

STATESVILLE 704-878-5305 MOORESVILLE 704-664-5281

IMPROVEMENT PERMIT / ~~CERTIFICATE OF COMPLETION~~ / OPERATION PERMIT / EXISTING SYSTEM INSPECTION

PROPERTY DESCRIPTION NO. 24297 DATE 8/8/96 TAX MAP NO. 2L-A-13 Pt of Watershed: ☑ Yes ☐ No

OWNER OR CONTRACTOR OREN EUGENE BYERS PHONE: Business 4627931810 Home 875-9546 WSIVCA

ADDRESS 12731 NEWSTEAD RD HUNTERSVILLE NC 28078

LOCATION BRAWLEY SCHOOL RD - TR BLUME RD - TL BEATEN PATH RD - 10TH LOT ON LEFT

SUBDIVISION SHAVENDER'S BLUFF BLOCK / SECTION LOT 34 LOT AREA 1.03 AC SITE CLASS. PS DESIGN FLOW 480GPD L.T.A.R. .3 GPD/FT²

Septic Tank: 1000 Gallons; STB 794 Date 5/15/97

Pump Tank: Gallons; PT Date

Pump Make: Model Serial No.

Nitrification Field: No Fields 1 Square Feet 1600 Linear Feet 533

No Lines 4 Trench Width 36" Max Trench Bottom Depth 36" Gravel Depth 12"

☑ New System ☐ Repair System Type: I II III IV V VI

System Description: GRAVITY CONVENTIONAL

Repair System Description: GRAVITY PANEL

Maintenance Agreement Required: ☐ Yes ☑ No

☑ House/Mod. Home No. Bedrooms 4

☐ Mobile Home No. Bathrooms 3.5

☐ Business No. Employees

☐ Other


☐ Slab ☑ Crawl Space ☐ Basement w/plumbing ☐ Basement wo/plumbing

Water Supply: ☑ Individual ☐ Community ☐ Public


Comments:

Comments:

INITIAL SITE SKETCH

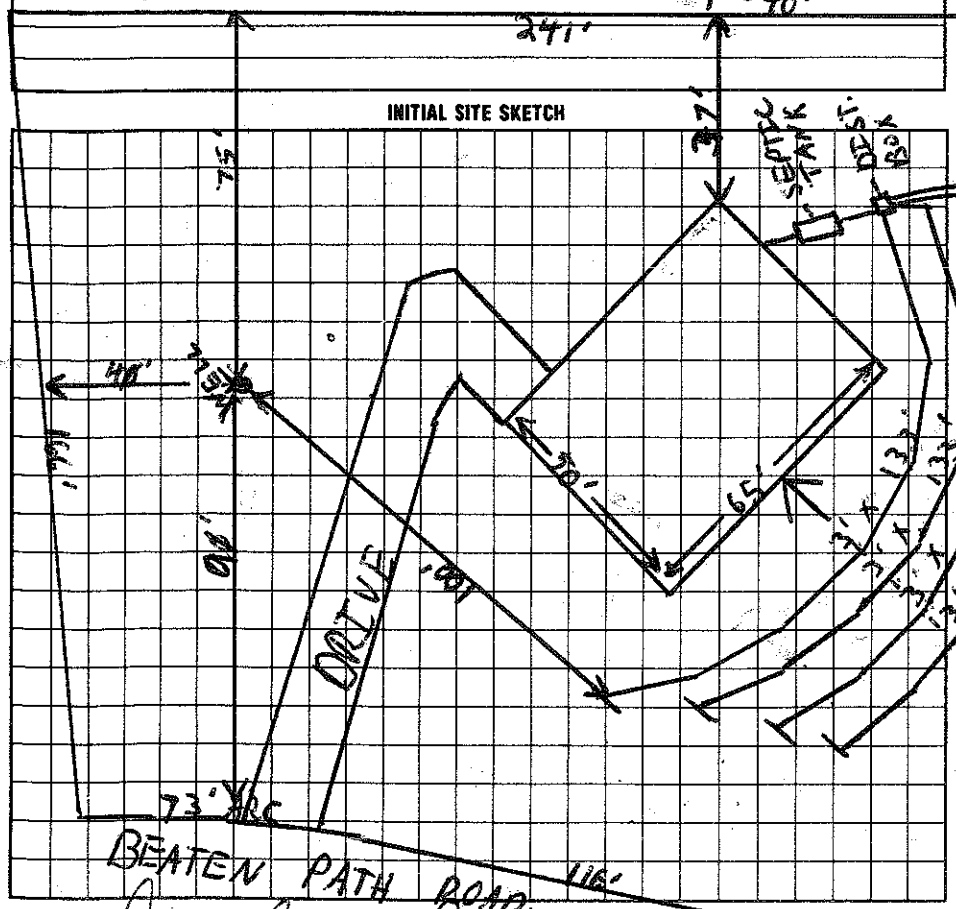

AS BUILT SKETCH

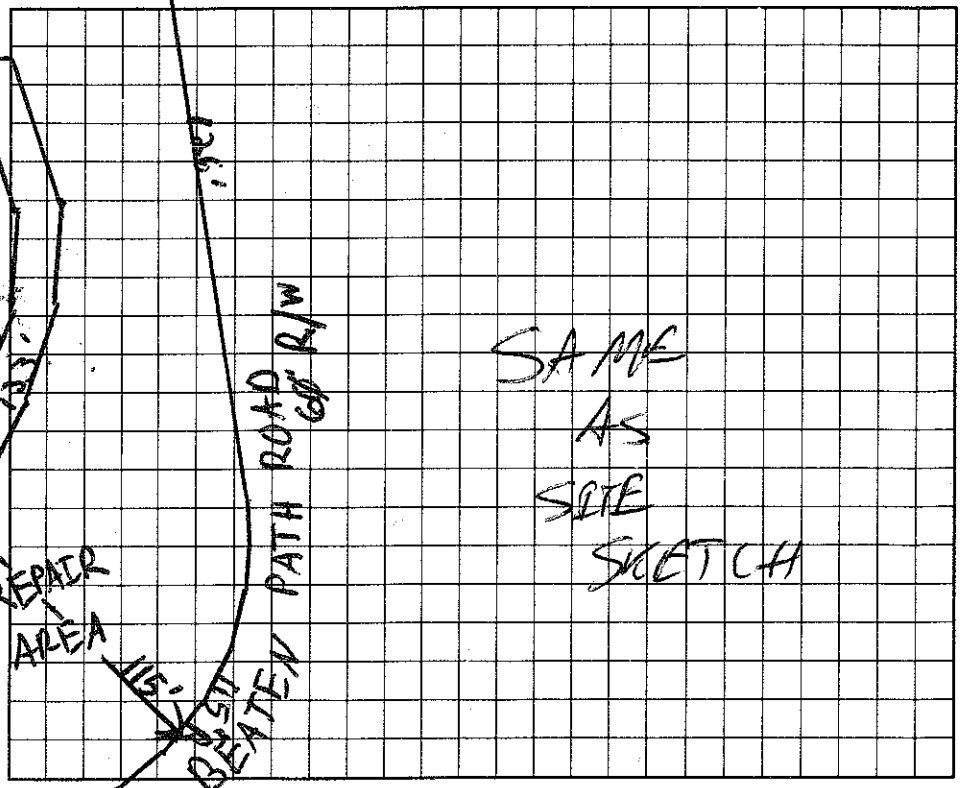

I understand that this permit can be suspended or revoked if any false information is supplied toward securing the permit/any unauthorized changes are made to the site/any unauthorized changes are made in the installation of the system.

Signed: Oren Eugene Byers

Installed by: BW CHRISTENBERRY

Improvement Permit by: C. Ray Thomas EHSE date 5/8/96

CONSTRUCTION Existing System Inspection by: C. Ray Thomas EHSE date 8/8/96

AUTHORIZATION

Certificate of Completion by: date

Operation Permit by: C. Ray Thomas date 5/14/97

HEALTH DEPT. COPY: WHITE INSPECTION COPY (FINAL): GREEN OWNER COPY (FINAL): YELLOW INSPECTION COPY (INITIAL): PINK OWNER COPY (INITIAL): GOLD

AUTHORIZATION TO CONSTRUCT IS VALID FOR 60 MONTHS FROM ISSUE DATE.