IREDELL COUNTY HEALTH DEPARTMENT

Authorization to Construct

4627932427

STATESVILLE 704-878-5305 MOORESVILLE 704-664-5281

IMPROVEMENT PERMIT / ~~CERTIFICATE OF COMPLETION~~ / OPERATION PERMIT / EXISTING SYSTEM INSPECTION

PROPERTY DESCRIPTION NO. 23877 DATE 6/3/96 TAX MAP NO. 2L-A-13 pt of Watershed: ☑ Yes ☐ No

OWNER OR CONTRACTOR ~~Charles Gerrish~~ Charles Gerrish PHONE: Business _____ Home 568-5134

ADDRESS 6231 W. Spruce Dr. New Holland, Pa 17557

LOCATION Brawley School Rd - TR Blume Rd - TL Beaver Path Rd lot 32 on left

SUBDIVISION Shroder Dev. BLOCK / SECTION _____ LOT 32 LOT AREA ± 1.769 ac SITE CLASS. PS DESIGN FLOW 480 gpd L.T.A.R. ≈ .35 gpd/ft²

Septic Tank: 1000 Gallons; STB 794 Date 1/29/97

Pump Tank: _____ Gallons; PT _____ Date _____

Pump Make: _____ Model _____ Serial No. _____

Nitrification Field: No Fields 1 Square Feet 1440 Linear Feet 480

No Lines 6 Trench Width 36" Max Trench Bottom Depth 36" Gravel Depth 12"

☑ New System ☐ Repair System Type: I (II) III. IV. V. VI

System Description: Gravity Conventional

Repair System Description: Gravity Panel

Maintenance Agreement Required: ☐ Yes ☑ No

☑ House/Mod. Home No. Bedrooms 4

☐ Mobile Home No. Bathrooms 3

☐ Business No. Employees _____

☐ Other _____


☐ Slab ☑ Crawl Space ☐ Basement w/plumbing ☐ Basement wo/plumbing

Water Supply: ☑ Individual ☐ Community ☐ Public

Comments:

Comments:

INITIAL SITE SKETCH 1"=50'

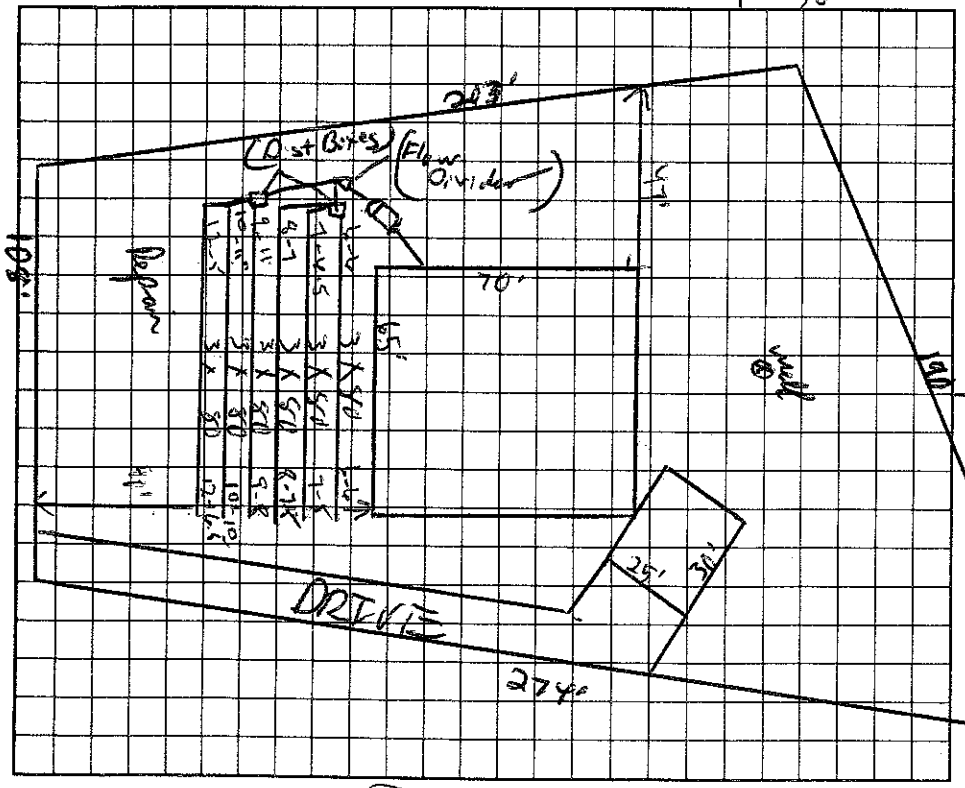

AS BUILT SKETCH

I understand that this ~~permit~~ can be suspended or revoked if any false information is supplied toward securing the permit/any unauthorized changes are made to the site/any unauthorized changes are made in the installation of the system.

Signed: _____

Installed by: Macleod Const. Co.

Improvement Permit by: C. Brightman EHSI date 6/3/96

Authorization to Construct ~~Existing System Inspection~~ by: C. Brightman date 6/3/96

Certificate of Completion by: _____ date _____

Operation Permit by: Wesley Sparks RS. date 3/17/97

HEALTH DEPT. COPY: WHITE INSPECTION COPY (FINAL): GREEN OWNER COPY (FINAL): YELLOW INSPECTION COPY (INITIAL): PINK OWNER COPY (INITIAL): GOLD