IREDELL COUNTY HEALTH DEPARTMENT

AUTHORIZATION TO CONSTRUCT

STATESVILLE 704-878-5305 MOORESVILLE 704-664-5281

IMPROVEMENT PERMIT / ~~CERTIFICATE OF COMPLETION~~ / OPERATION PERMIT / EXISTING SYSTEM INSPECTI

PROPERTY DESCRIPTION NO. 067750 DATE 6/30/97 TAX MAP NO. 462 791 2791 4627 93 3098 Watershed: ☑ Yes

OWNER OR CONTRACTOR [redacted] JAMIE ROLEWICZ PHONE: Business 663-6905 T. JACOBS Home

ADDRESS 11423-D EXECUTIVE CIRCLE CARY NC 27511

LOCATION BRAWLEY SCHOOL RD - TR BLUME - TL BEATEN - TL DOBBIN CT - 5TH LOT ON RT

SUBDIVISION SHAVENDERS BLUFF BLOCK / SECTION 2 LOT 145 LOT AREA .734C SITE CLASS. PS DESIGN FLOW 480 GPD L.T.A.R. .35 GPD/FT²

Septic Tank: 1000 Gallons; STB 194 Date 9/22/97

Pump Tank: 1 Gallons; PT 27 Date 10/24/97

Pump Make: HYDROMATIC Model 3K50A1 Serial No. 9797

Nitrification Field: No Fields 1 Square Feet 750 Linear Feet 350

No Lines 6 Trench Width 36" Max Trench Bottom Depth 36" Gravel Depth N/A

☑ New System ☐ Repair System Type: I, II, (III), IV, V, VI

System Description: PUMP [redacted] CHAMBERED OR SIMILAR

Repair System Description: PUMP PANEL

Maintenance Agreement Required: ☐ Yes ☑ No

☑ House/Mod. Home No. Bedrooms 4

☐ Mobile Home No. Bathrooms 4

☐ Business No. Employees ____

☐ Other ____

☐ Slab ☑ Crawl Space ☐ Basement w/plumbing ☐ Basement wo/plumbing


Water Supply:
☑ Individual
☐ Community
☐ Public

Comments: PUMP CHAMBERED OR SIMILAR TYPE


Comments:

1"=40'

INITIAL SITE SKETCH

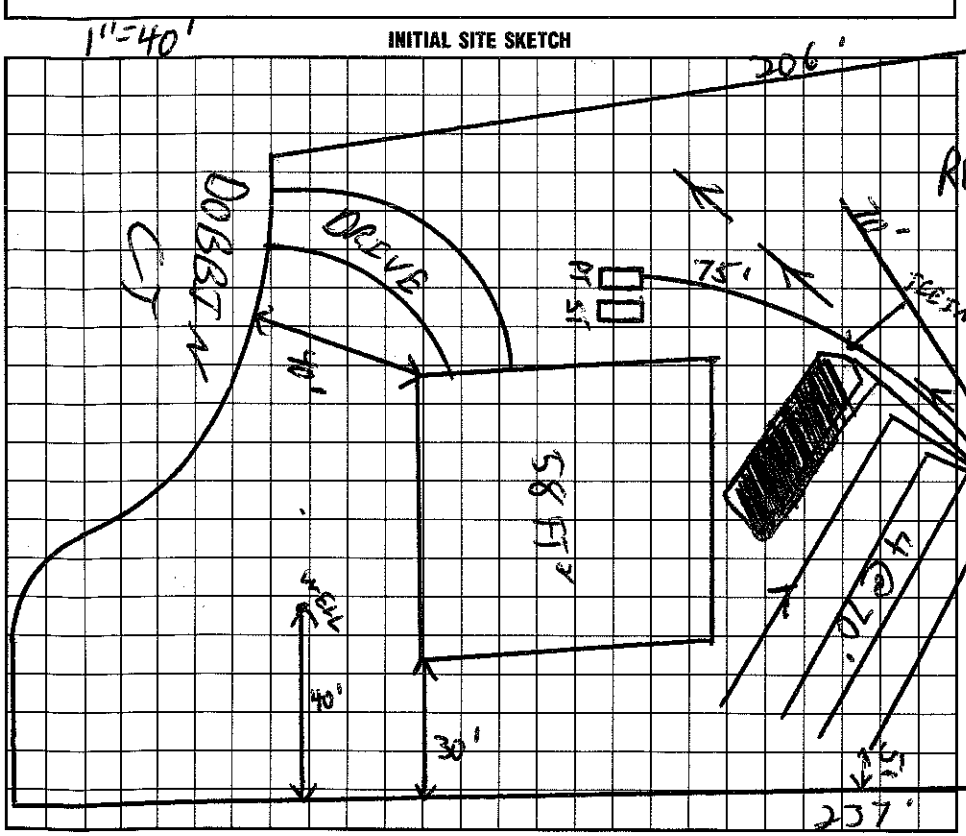

AS BUILT SKETCH

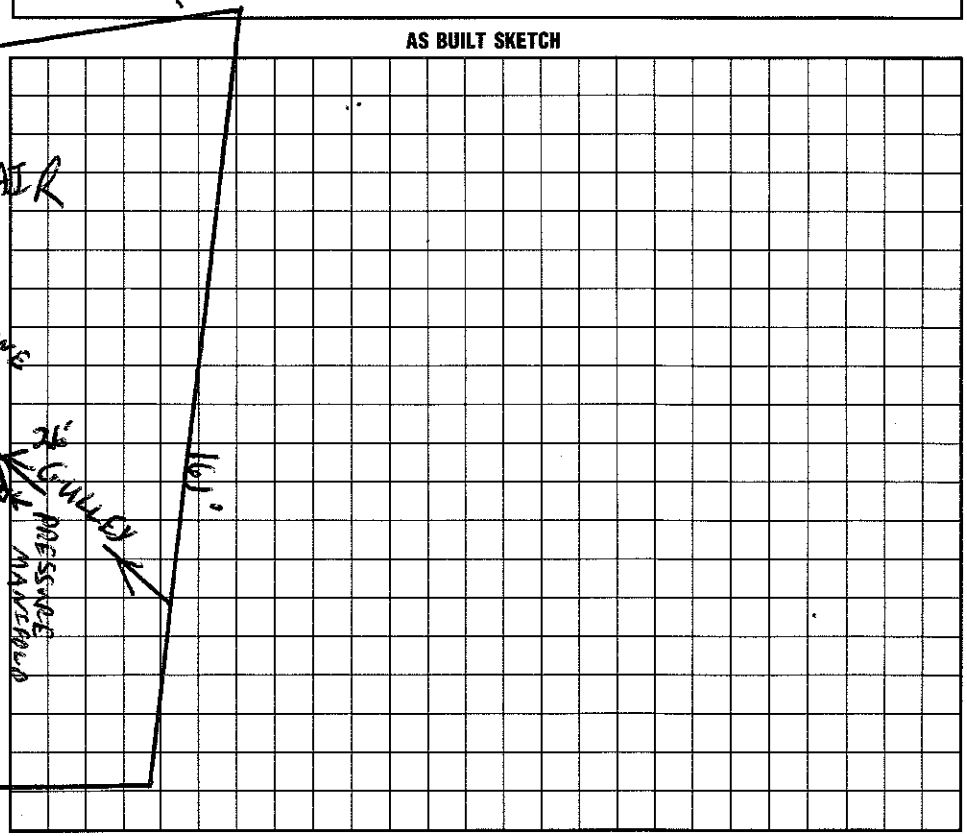

I understand that this permit can be suspended or revoked if any false information is supplied toward securing the permit/any unauthorized changes are made to the site/any unauthorized changes are made in the installation of the system. Improvement Permit is valid for 60 months from date of issuance.

Signed: Lonnie Hullum

Improvement Permit by: C. Ray Fenn date 6/30/97

AUTHORIZATION TO CONSTRUCT ~~Existing System Inspection by~~: C. Ray Fenn date 8/20/97

Installed by: Larry Beam

Certificate of Completion by: Wesley Sparks RS date 12/15/97

Operation Permit by: Wesley Sparks RS date 12/15/97

HEALTH DEPT. COPY: WHITE INSPECTION COPY (FINAL): GREEN OWNER COPY (FINAL): YELLOW INSPECTION COPY (INITIAL): PINK OWNER COPY (INITIAL): GOLD