IREDELL COUNTY HEALTH DEPARTMENT

Authorization to Construct

STATESVILLE 704-878-5305 MOORESVILLE 704-664-5281

IMPROVEMENT PERMIT / ~~CERTIFICATE OF COMPLETION~~ / OPERATION PERMIT / EXISTING SYSTEM INSPECTION

PROPERTY DESCRIPTION NO 19419 DATE Nov. 22, '94 TAX MAP NO. part of 2L 4A 99 Watershed: ☑ Yes ☐ No

OWNER OR CONTRACTOR Julianne K. Jones PHONE: Business Home LN WSIV

ADDRESS PO Box 2621, Cornelius 358 Beaton Path

LOCATION 1100 TR 1178 (Blume) TL Beaton Path ~ 1 mile on Rt.

SUBDIVISION Crescent LN BLOCK / SECTION 9 LOT 99A LOT AREA .85 Ac SITE CLASS. B per 1956 DESIGN FLOW 480 gpd L.T.A.R. .3

Septic Tank: 1000 Gallons; STB 794 Wellinger Date 1-10-95

Pump Tank: 1000 Gallons; PT 270 Wellinger Date 8-14-95

Pump Make: _____ Model _____ Serial No. _____

Nitrification Field: No Fields 1 Square Feet _____ Linear Feet 270

No Lines 4 Trench Width 24" Max Trench Bottom Depth 30" Gravel Depth NA

☑ New System ☐ Repair System Type: I, II, III, ⓘ V, VI

System Description: LP PPBPS

Repair System Description: SAME

Maintenance Agreement Required: ☑ Yes ☐ No

☑ House/Mod. Home No. Bedrooms 4

☐ Mobile Home No. Bathrooms 3½

☐ Business No. Employees _____

☐ Other _____


☐ Slab ☐ Crawl Space ☑ Basement w/plumbing ☐ Basement wo/plumbing

Water Supply: ☑ Individual ☐ Community ☐ Public

Comments: Pre-installation visit w/ ST installer required. Laterals to follow contour.

Comments: Installed in 3 laterals

INITIAL SITE SKETCH

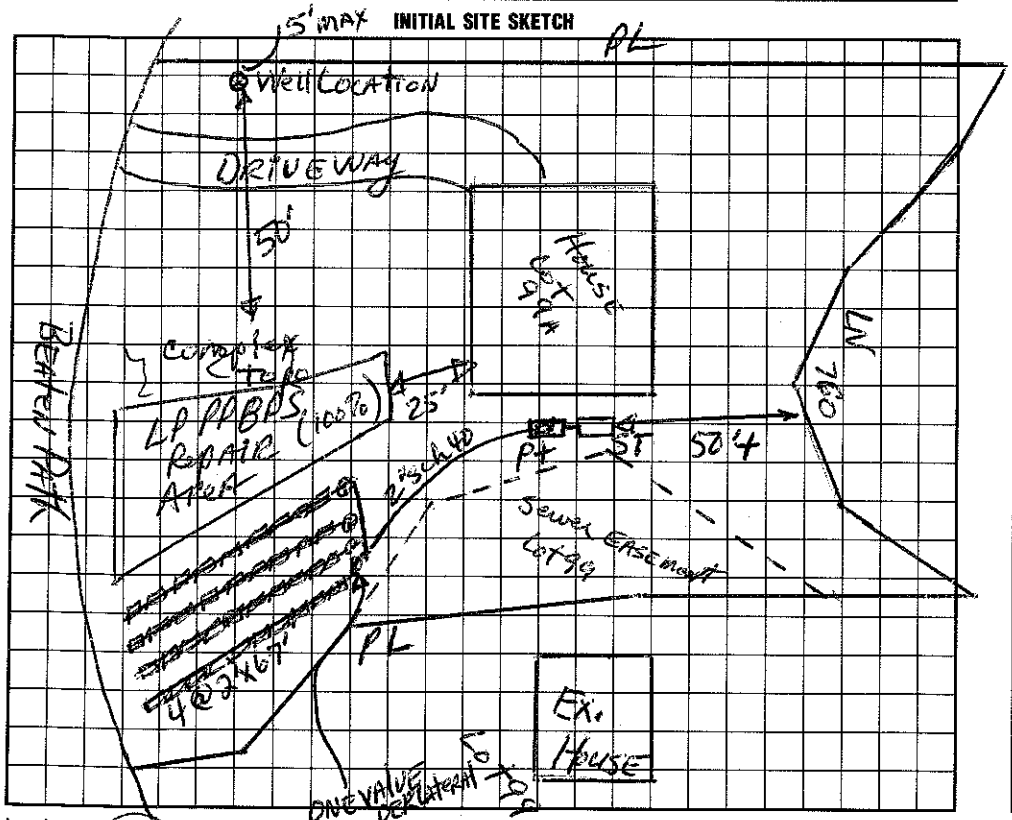

AS BUILT SKETCH

I understand that this permit can be suspended or revoked if any false information is supplied toward securing the permit/any unauthorized changes are made to the site/any unauthorized changes are made in the installation of the system. Improvement Permit is valid for 60 months from date of issuance.

Signed: [signature]

Improvement Permit by: [signature], RS date 11/22/94

Existing System Inspection by: _____ date _____

Installed by: F. J. Ervin

Certificate of Completion by: Wesley Sparks RS date 12/8/95

Operation Permit by: Wesley Sparks RS date 12/8/95

HEALTH DEPT. COPY: WHITE INSPECTION COPY (FINAL): GREEN OWNER COPY (FINAL): YELLOW INSPECTION COPY (INITIAL): PINK OWNER COPY (INITIAL): GOLD