IREDELL COUNTY HEALTH DEPARTMENT

STATESVILLE 704-878-5305 MOORESVILLE 704-664-5281

IMPROVEMENT PERMIT / AUTHORIZATION TO CONSTRUCT / OPERATION PERMIT / EXISTING SYSTEM INSPECTION

PERMIT # EXISTING PIN # 4627-93-4649 DATE 10-1-09

OWNER or APPLICANT KELLY IRELAND PHONE: Business 704-664-5211 Home:

OWNER or APPLICANT ADDRESS 350 BEATEN PATH RD MVILLE 28117

LOCATION / DIRECTIONS BSR, TR BLUME, TL BEATEN PATH

SUBDIVISION CLTT BLOCK / SECTION 9 LOT # 99 LOT AREA .88AC DESIGN FLOW [redacted] L.T.A.R.

Septic Tank ____ Gallons: STB ____ Date ____
Pump Tank ____ Gallons: PT ____ Date ____
Pump Make ____ Model EXISTING Serial # ____
Nitrification Field No Fields ____ No Lines ____ Linear Feet ____
Trench Width ____ Max. Trench Bottom Depth ____ Gravel Depth ____

☐ New System ☐ Repair ☐ Expansion System Type (I) II III IV V VI
System Description: GRAVEL BED
Repair System Description:
Maintenance Agreement Required ☐ YES ☒ NO
☒ GRAVITY ☐ PRESSURE

☒ Residence No. Bedrooms [redacted]
☐ Business No. Persons ____
☐ Other No. Employees ____
☐ Slab ☐ Crawl Space
☒ Basement w/plumbing ☐ Basement w/o plumbing


Water Supply: ☒ Private ☐ Public ☐ Community

Comments / Conditions 1) SEPTIC DOES NOT MEET REQUIREMENTS FOR 3 BEDROOMS. IF HOUSE IS SOLD, WILL NEED UPGRADE

Comments / Conditions LAKE

INITIAL SITE SKETCH

AS BUILT SKETCH

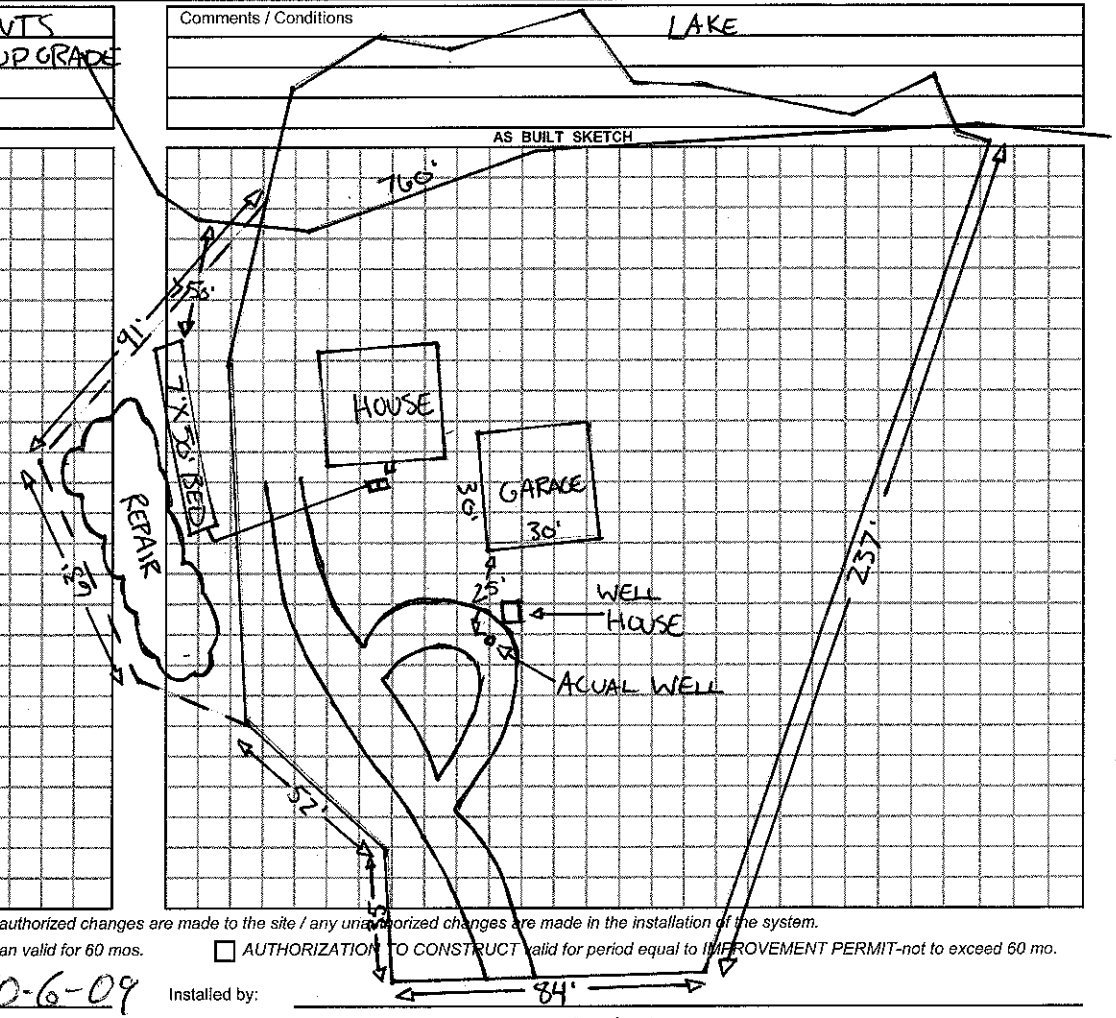

Permit can be suspended or revoked if any false information is supplied toward securing the permit / any unauthorized changes are made to the site / any unauthorized changes are made in the installation of the system.

☐ *IMPROVEMENT PERMIT w / plat valid without expiration.* ☐ *IMPROVEMENT PERMIT w / site plan valid for 60 mos.* ☐ *AUTHORIZATION TO CONSTRUCT valid for period equal to IMPROVEMENT PERMIT-not to exceed 60 mo.*

Owner / Applicant Signature: [signature] Date 10-6-09

Improvement Permit by: ____ Date ____

Authorization to Construct by: ____ Date ____

Installed by: ____

Operation Permit by: BEATEN PATH RD Date: ____

Existing System Inspected by: [signature] RS. Date: 10-2-09

YOU SHOULD CONTACT A LOCATOR SERVICE PRIOR TO ANY EXCAVATION.

WHITE COPY Environmental Health YELLOW COPY (Final) Owner / Applicant PINK COPY (Initial) Owner / Applicant