IREDELL COUNTY HEALTH DEPARTMENT

AUTHORIZATION TO CONSTRUCT

STATESVILLE 704-878-5305 MOORESVILLE 704-664-5281

IMPROVEMENT PERMIT / ~~CERTIFICATE OF COMPLETION~~ / OPERATION PERMIT / EXISTING SYSTEM INSPECTION

PROPERTY DESCRIPTION NO. 065669 DATE 4/15/97 TAX MAP NO. 4627935327 Watershed: ☑ Yes ☐ No

OWNER OR CONTRACTOR W.E. MEYER INC PHONE: Business _____ Home 549-7644

ADDRESS 2201 CENTER DR. CHARLOTTE NC 28277

LOCATION BRAWLEY SCHOOL RD - TR BLUME RD - TL BEATEN PATH - ON LEFT

SUBDIVISION SHAVENDER'S ~~Run~~ BLOCK / SECTION 1B LOT 30 LOT AREA .71 AC SITE CLASS. PS DESIGN FLOW 360 GPD L.T.A.R. .36 GPD/FT

Septic Tank: 1000 Gallons; STB _____ Date _____

Pump Tank: 1000 Gallons; PT _____ Date _____

Pump Make: H40 ROMATIK Model ME-60A1 Serial No. 2-98

Nitrification Field: No Fields 1 Square Feet 400 Linear Feet 260

No Lines 4@50' Trench Width 24" Max Trench Bottom Depth 36" Gravel Depth N/A

☑ New System ☐ Repair System Type: I, II, (III), IV, V, VI

System Description: PUMP PANEL

Repair System Description: SAME

Maintenance Agreement Required: ☐ Yes ☑ No

☑ House/Mod. Home No. Bedrooms 3

☐ Mobile Home No. Bathrooms 2

☐ Business No. Employees _____

☐ Other _____


☐ Slab ☐ Crawl Space ☑ Basement w/plumbing ☐ Basement wo/plumbing

Water Supply: ☑ Individual ☐ Community ☐ Public

Comments:

Comments: ½ BASEMENT

INITIAL SITE SKETCH 1"=50'

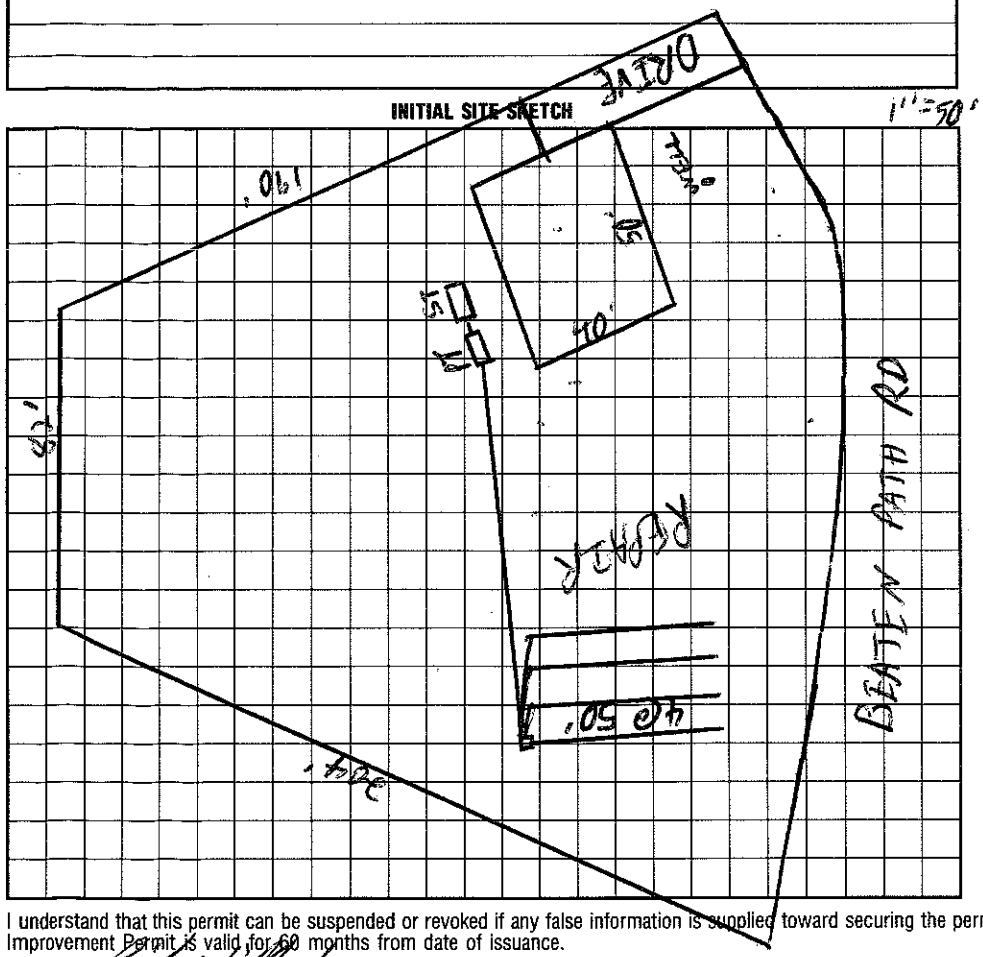

AS BUILT SKETCH

I understand that this permit can be suspended or revoked if any false information is supplied toward securing the permit/any unauthorized changes are made to the site/any unauthorized changes are made in the installation of the system. Improvement Permit is valid for 60 months from date of issuance.

Signed: Kenny Williams

Improvement Permit by: C. Ray Green EHSI date 4/15/97

~~Existing System Inspection by:~~ AUTHORIZATION TO CONSTRUCT C. Ray Green EHSI date 4/15/97

Installed by: Kenny Williams

Certificate of Completion by: _____ date _____

Operation Permit by: Wesley Starnes RS. date 11/2/98

HEALTH DEPT. COPY: WHITE INSPECTION COPY (FINAL): GREEN OWNER COPY (FINAL): YELLOW INSPECTION COPY (INITIAL): PINK OWNER COPY (INITIAL): GOLD