IREDELL COUNTY HEALTH DEPARTMENT

STATESVILLE 704-878-5305 130.00 Paid MOORESVILLE 704-664-5281

IMPROVEMENT PERMIT / AUTHORIZATION TO CONSTRUCT / OPERATION PERMIT / EXISTING SYSTEM INSPECTION

PERMIT# 109198 PIN# 4627936039 DATE 10-29-2002

OWNER OR CONTRACTOR William Whitlow PHONE: Business 400-2454 Home 664-2581

ADDRESS 134 Ensign Ln Mooresville NC 28117

LOCATION Brawley School Rd TR Blume TL Beaten Path ~ 1½ miles on left

SUBDIVISION Shavenders Bluff BLOCK / SECTION ____ LOT 28 LOT AREA .77 Acre SITE CLASS PS DESIGN FLOW 480 gpd L.T.A.R. .35

Septic Tank: 1000 Gallons; STB 794 Date 2-3-04

Pump Tank: ____ Gallons; PT ____ Date ____

Pump Make: ____ Model ____ Serial No. ____

Nitrification Field: No Fields 1 Square Feet 750 Linear Feet 250

No Lines 5 @ 50' Trench Width 24" Max Trench Bottom Depth 30" Gravel Depth N/A

[X] New System [ ] Repair System Type: I, II, III, IV, V, VI

System Description: Gravity - Panel Blk

Repair System Description: Pump up - Panel Blk

Maintenance Agreement Required: [ ] Yes [X] No Initially for

[X] House/Mod. Home [ ] Mobile Home [ ] Business [ ] Other

No. Bedrooms 4 No. Bathrooms 3.5 No. Employees ____


[ ] Slab [ ] Crawl Space [ ] Basement w/plumbing [X] Basement wo/plumbing

Water Supply: [X] Individual [ ] Public [ ] Community

Comments/Conditions: Keep Septic System at least 10' From PL & 15' From Roadcut & 25' from basement unless upgradient, 15' if side gradient.

Comments/Conditions: Note: Owner choses to use "Grinder Pump" if basement plumbing installed.

INITIAL SITE SKETCH Scale 1"=50'

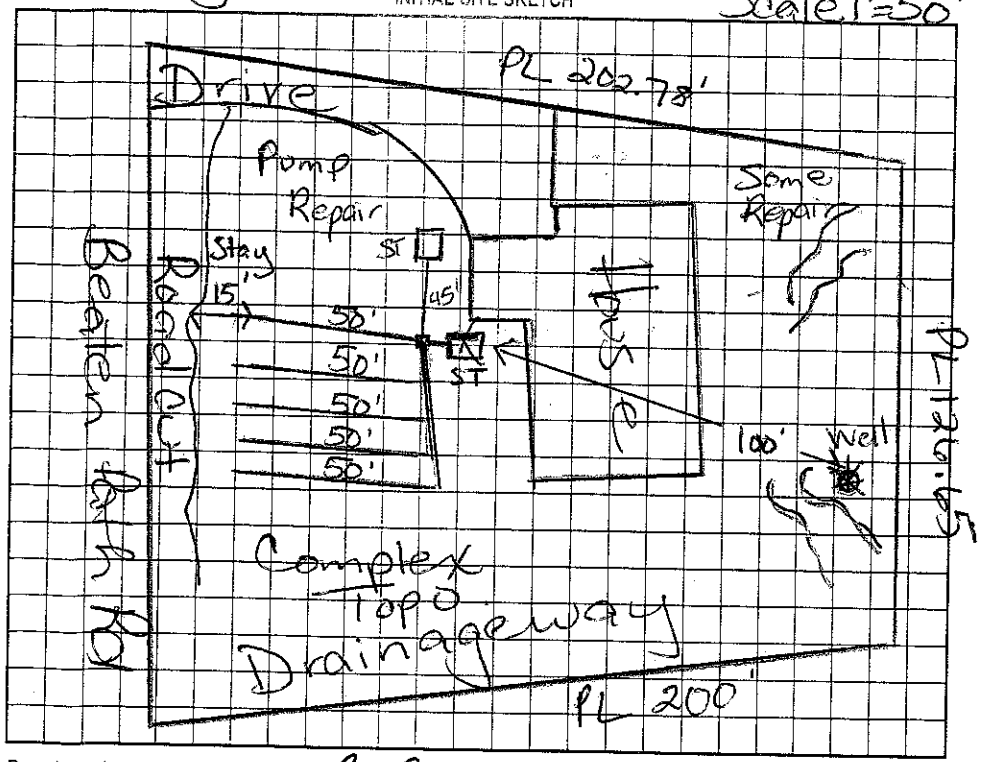

AS BUILT SKETCH

Note: ~ 45' between ST & D-box

Permit can be suspended or revoked if any false information is supplied toward securing the permit/any unauthorized changes are made to the site/any unauthorized changes are made in the installation of the system. Improvement Permit with plat valid without expiration. Improvement Permit with site plan valid for sixty months. Authorization to Construct is valid for a period equal to that of Improvement Permit – not to exceed sixty months.

Signed: W.P. Whitlow date 11-01-02 Installed by: Richard Abernathy

Improvement Permit by: Maria H. Holston RS date 10/29/02 Operation Permit by: Maria H. Holston R.S. date 5/19/04

Authorization to Construct by: Maria H. Holston RS date 10/30/02 Existing System Inspection by: ____ date ____

HEALTH DEPT. COPY: WHITE OWNER COPY (FINAL): YELLOW OWNER COPY (INITIAL): PINK