IREDELL COUNTY HEALTH DEPARTMENT

Authorization to Construct

STATESVILLE 704-878-5305 MOORESVILLE 704-664-5281

400

IMPROVEMENT PERMIT / ~~CERTIFICATE OF COMPLETION~~ / OPERATION PERMIT / EXISTING SYSTEM INSPECTION

PROPERTY DESCRIPTION NO. 25726 DATE 6/26/97 TAX MAP NO. 2L 4A 29 4627 93 6215 Watershed: X Yes ☐ No

OWNER OR CONTRACTOR Steve Bobenski PHONE: Business _____ Home 663-6432

ADDRESS Beaten Path Rd. Mooresville, NC. 28115

LOCATION 1100 TR Blume Rd. TL Beaten Path, 4th on (L) past Newland Ln.

SUBDIVISION Shoreacres Bluff BLOCK / SECTION 1B LOT 29 LOT AREA .73 SITE CLASS P5 DESIGN FLOW 480 L.T.A.R. .3

Septic Tank: 1000 Gallons; STB 794 Date _____

Pump Tank: 1000 Gallons; PT 27 Date _____

Pump Make: _____ Model _____ Serial No. _____

Nitrification Field: No Fields 1 Square Feet 534* Linear Feet 267*

No Lines 5 or 6 Trench Width 24" Max Trench Bottom Depth 36" Gravel Depth SAND

X New System ☐ Repair System Type: I, II, (III), IV, V, VI

System Description: PRESMAN → 16" PPBS

Repair System Description: SAME

Maintenance Agreement Required: ☐ Yes X No

X House/Mod. Home No. Bedrooms 4

☐ Mobile Home No. Bathrooms 3

☐ Business No. Employees _____

☐ Other _____


☐ Slab X Crawl Space ☐ Basement w/plumbing ☐ Basement wo/plumbing

Water Supply: X Individual ☐ Community ☐ Public


Comments: * 50% reduction for use of 16" Prefb. Panel Block

Comments:

INITIAL SITE SKETCH

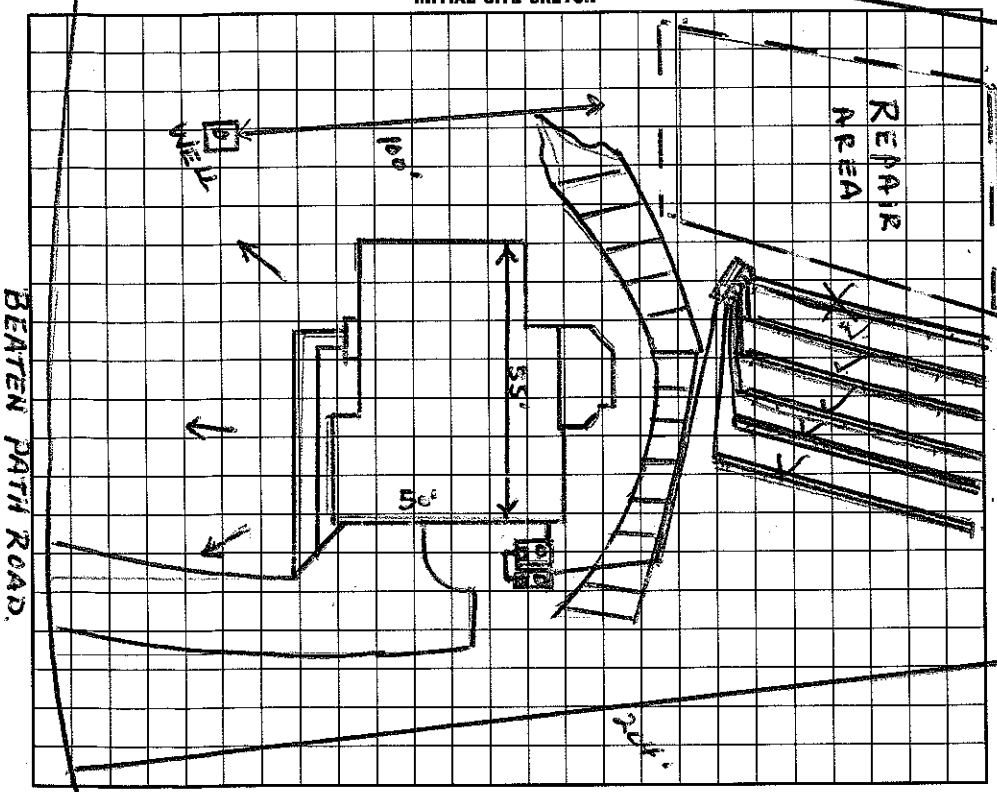

AS BUILT SKETCH

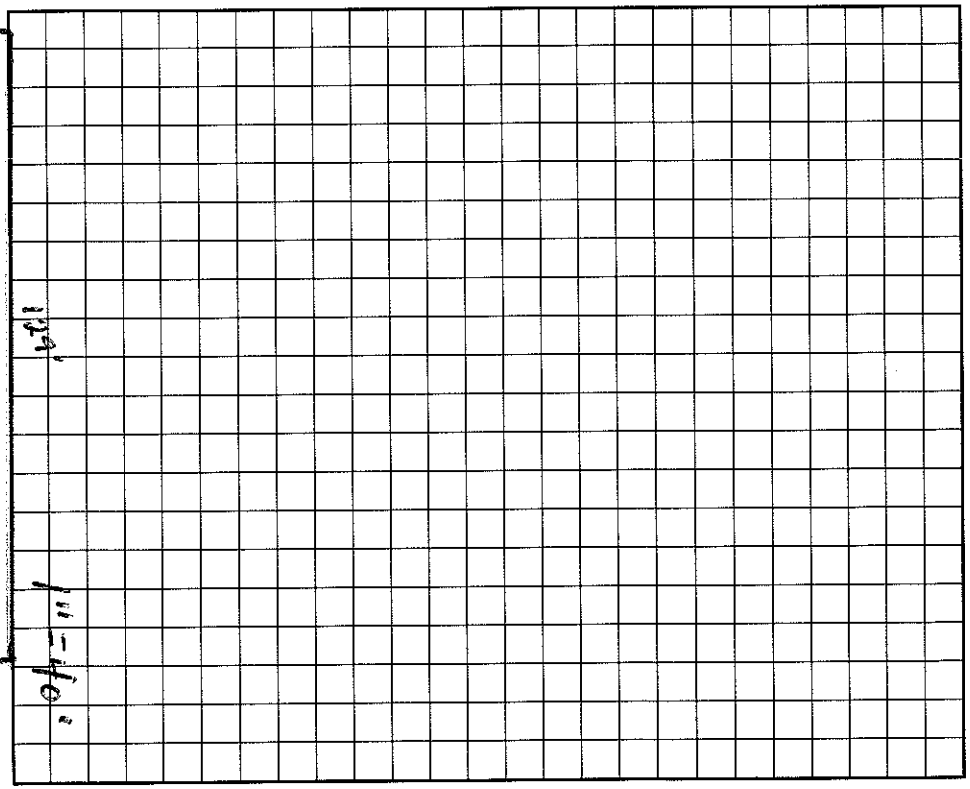

I understand that this permit can be suspended or revoked if any false information is supplied toward securing the permit/any unauthorized changes are made to the site/any unauthorized changes are made in the installation of the system. Improvement Permit is valid for 60 months from date of issuance.

Signed: *

Improvement Permit by: Wesley Sparks R.S. date 6/26/97

System Inspection by: Wesley Sparks R.S. date 6/26/97

Installed by: Curt Dunning

Certificate of Completion by: Wesley Sparks R.S. date 7/16/97

Operation Permit by: Wesley Sparks R.S. date 7/16/97

DEPT. COPY: WHITE INSPECTION COPY (FINAL): GREEN OWNER COPY (FINAL): YELLOW INSPECTION COPY (INITIAL): PINK OWNER COPY (INITIAL): GOLD