IREDELL COUNTY HEALTH DEPARTMENT

STATESVILLE 704-878-5305 MOORESVILLE 704-664-5281

IMPROVEMENT PERMIT / AUTHORIZATION TO CONSTRUCT / OPERATION PERMIT / EXISTING SYSTEM INSPECTION

PERMIT# 074737 PIN# 4027936650 DATE 7/31/98

OWNER OR CONTRACTOR Tom Delantonas PHONE: Business Home

ADDRESS 336 Beaten Path Mooresville, NC 28115

LOCATION

SUBDIVISION LOT BLOCK / SECTION 9 LOT 100 LOT AREA .76 Acre SITE CLASS. DESIGN FLOW L.T.A.R. may add Study

Septic Tank: 1000 Gallons; STB Date

Pump Tank: Gallons; PT Date

Pump Make: Existing Model Serial No.

Nitrification Field: No Fields Square Feet Linear Feet

No Lines Trench Width Max Trench Bottom Depth Gravel Depth

☐ New System ☐ Repair System Type: I, II, III, IV, V, VI

System Description: Gravity

Repair System Description: Existing

Maintenance Agreement Required: ☐ Yes ☐ No

☒ House/Mod. Home No. Bedrooms 3

☐ Mobile Home No. Bathrooms 3

☐ Business No. Employees

☐ Other


☐ Slab ☐ Crawl Space ☒ Basement w/plumbing ☐ Basement wo/plumbing

Water Supply: ☒ Individual ☐ Public ☐ Community

Comments/Conditions: Existing System appears to be functioning okay, No problems with system were noticed. Septic System sized for 3 Bedroom

Comments/Conditions: Keep House 10' from Septic System & 15' (Side gradient) of Basement Wall Do Not cutt/grade lot deeper than Septic System. (Basement floor should be higher than Drainfield)

INITIAL SITE SKETCH * Not to Scale

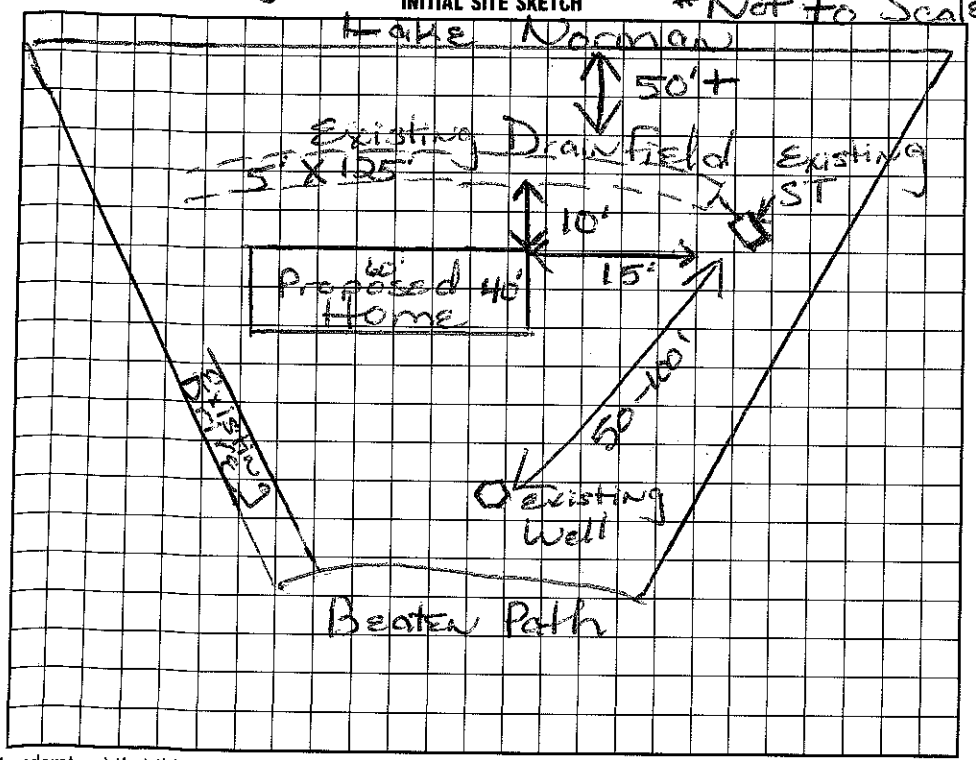

AS BUILT SKETCH

Note: Owner will use Grinder pump for any plumbing in basement

I understand that this permit can be suspended or revoked if any false information is supplied toward securing the permit/any unauthorized changes are made to the site/any unauthorized changes are made in the installation of the system. Improvement Permit with plat valid without expiration. Improvement Permit with site plan valid for sixty months. Authorization to Construct is valid for a period equal to that of Improvement Permit – not to exceed sixty months.

Signed: X Tom Delantonas date 7/31/98 Installed by:

Improvement Permit by: Maria H. Dotson date 7/31/98 Operation Permit by: date

Authorization to Construct by: Maria H. Dotson date 7/31/98 Existing System Inspection by: Maria Dotson date 7/31/98

HEALTH DEPT. COPY: WHITE INSPECTION COPY (FINAL): GREEN OWNER COPY (FINAL): YELLOW INSPECTION COPY (INITIAL): PINK OWNER COPY (INITIAL): GOLD