As Built..

IREDELL COUNTY HEALTH DEPARTMENT

STATESVILLE 704-878-5305 MOORESVILLE 704-664-5281

IMPROVEMENT PERMIT / AUTHORIZATION TO CONSTRUCT / OPERATION PERMIT / EXISTING SYSTEM INSPECTION

PERMIT# 127250 PIN# 4627 94 2044 DATE 3-20-06

OWNER OR APPLICANT Jack Turner PHONE: Business _____ Home _____

ADDRESS 374 Beaten Path Rd Mooresville, NC

LOCATION _____

SUBDIVISION C L & T BLOCK / SECTION 9 LOT 96 LOT AREA .67 Acre SITE CLASS. PS DESIGN FLOW 360 gpd T.A.R. .3

Septic Tank: 1000 Gallons; STB _____ Date _____

Pump Tank: 1000 Gallons; PT _____ Date _____

Pump Make: Myers Model 311-M Serial No. _____

Nitrification Field: No. Fields 1 Square Feet 400' Linear Feet 200

No Lines 7 Total Trench Width 24" Max Trench Bottom Depth 36" Gravel Depth N/A

☒ New System ☐ Repair ☐ Expansion System Type: I II III IV V VI

System Description: Pump-LP-Panel Block

Repair System Description: Limited, 1945C

Maintenance Agreement Required: ☒ Yes ☐ No

☒ House/Mod. Home ☐ Mobile Home ☐ Business ☐ Other

No. Bedrooms 3 No. Persons ____ No. Employees ____


Water Supply: ☒ Individual ☐ Public ☐ Community

☐ Gravity ☒ Pressure ☐ Slab ☐ Crawl Space ☒ Basement w/plumbing ☐ Basement wo/plumbing


Comments/Conditions: 5 In Use

Comments/Conditions: Some Repair

INITIAL SITE SKETCH

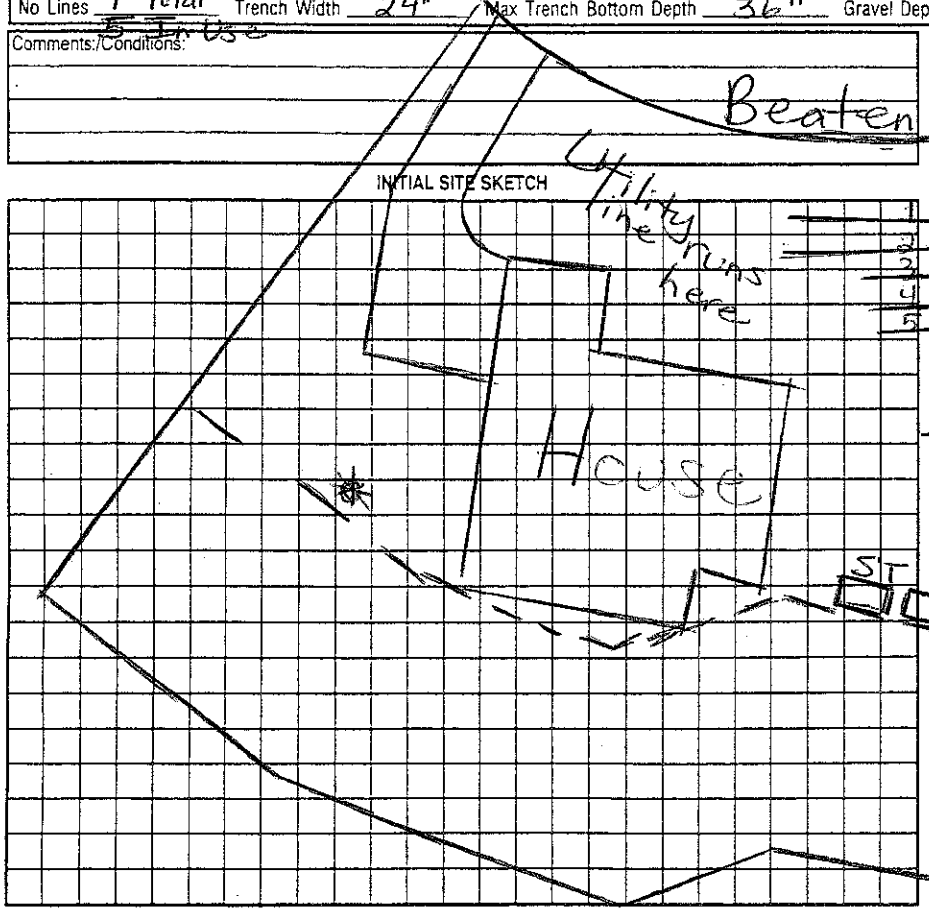

AS BUILT SKETCH

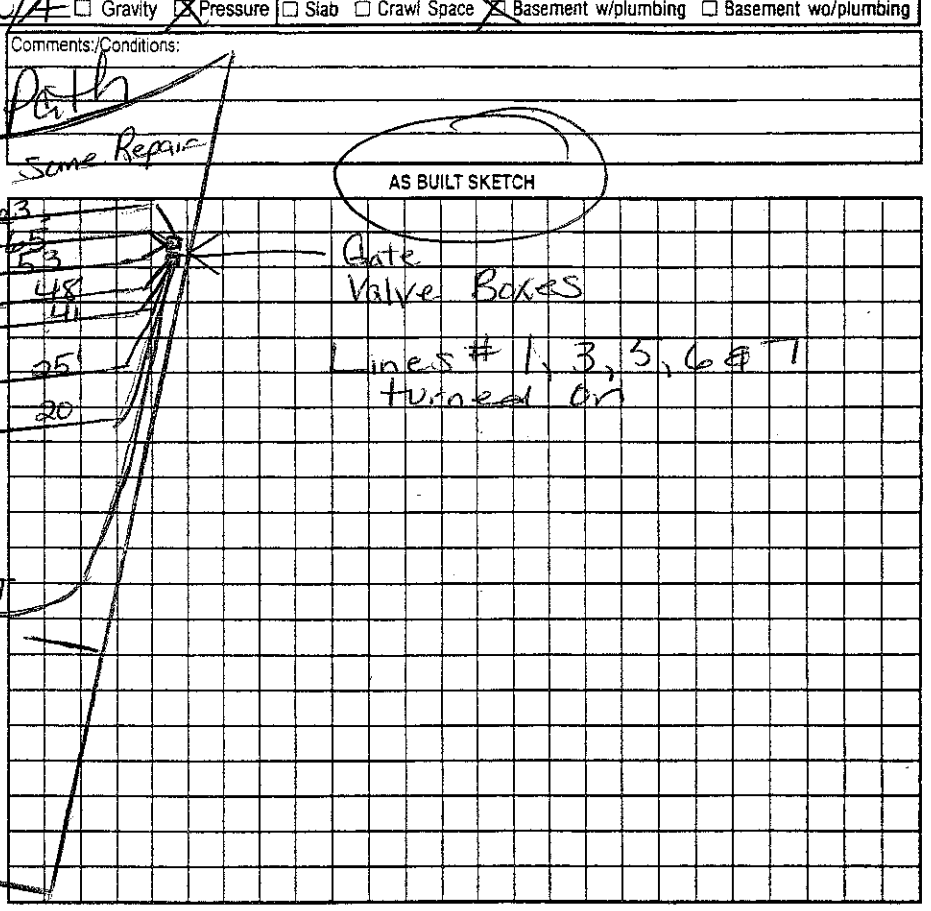

Permit can be suspended or revoked if any false information is supplied toward securing the permit/any unauthorized changes are made to the site/any unauthorized changes are made in the installation of the system. Improvement Permit with plat valid without expiration ☐ Improvement Permit with site plan valid for sixty months ☐ Authorization to Construct is valid for a period equal to that of Improvement Permit – not to exceed sixty months.

Signed: _____ date _____

Improvement Permit by: _____ date _____

Authorization to Construct by: _____ date _____

Installed by: Piedmont Septic

Operation Permit by: Marvin Hall Watson RS date 3/20/06

Existing System Inspection by: _____ date _____

HEALTH DEPT. COPY: WHITE OWNER COPY (FINAL): YELLOW OWNER COPY (INITIAL): PINK