IREDELL COUNTY HEALTH DEPARTMENT

STATESVILLE 704-878-5305 MOORESVILLE 704-664-5281

745.00 Paid

IMPROVEMENT PERMIT / AUTHORIZATION TO CONSTRUCT / OPERATION PERMIT / EXISTING SYSTEM INSPECTION

PERMIT# 113079 PIN# 4627-95-9283 David Mann (contractor) DATE 6/10/04

OWNER OR CONTRACTOR Roger Frost PHONE: Business 704 361-7126 Home 336-996-2684

ADDRESS 1190 Murrieta Dr. Kernersville NC 27284

LOCATION 150' W, TL McCary, TR Riverwood on Lt

SUBDIVISION GLFT BLOCK / SECTION 10 LOT 81 LOT AREA 0.78 AC SITE CLASS PS DESIGN FLOW 450 L.T.A.R. 0.3

Septic Tank: 1000 Gallons; STB 794 Date 3/4/04
Pump Tank: 1000 Gallons; PT 27 Date 6/23/04
Pump Make: Goulds Model WED5T24HC Serial No.
Nitrification Field: No Fields 1 Square Feet 810 Linear Feet 270
No Lines 4 Trench Width 24" on 36" Max Trench Bottom Depth 36" Gravel Depth —

☒ New System ☐ Repair System Type: I, II, III, (IV), V, VI
System Description: LP Panel Block
Repair System Description: Deeded Prior to 1983
Maintenance Agreement Required: ☒ Yes ☐ No


☒ House/Mod. Home ☐ Mobile Home ☐ Business ☐ Other
No. Bedrooms 4 No. Bathrooms 3½ No. Employees
☐ Slab ☐ Crawl Space ☒ Basement w/plumbing ☐ Basement wo/plumbing

Water Supply: ☒ Individual ☐ Public ☐ Community
Existing


Comments:/Conditions: 850 gal 750 gal 1" = 40'

Comments:/Conditions: 61 Panels 3/16" holes

INITIAL SITE SKETCH

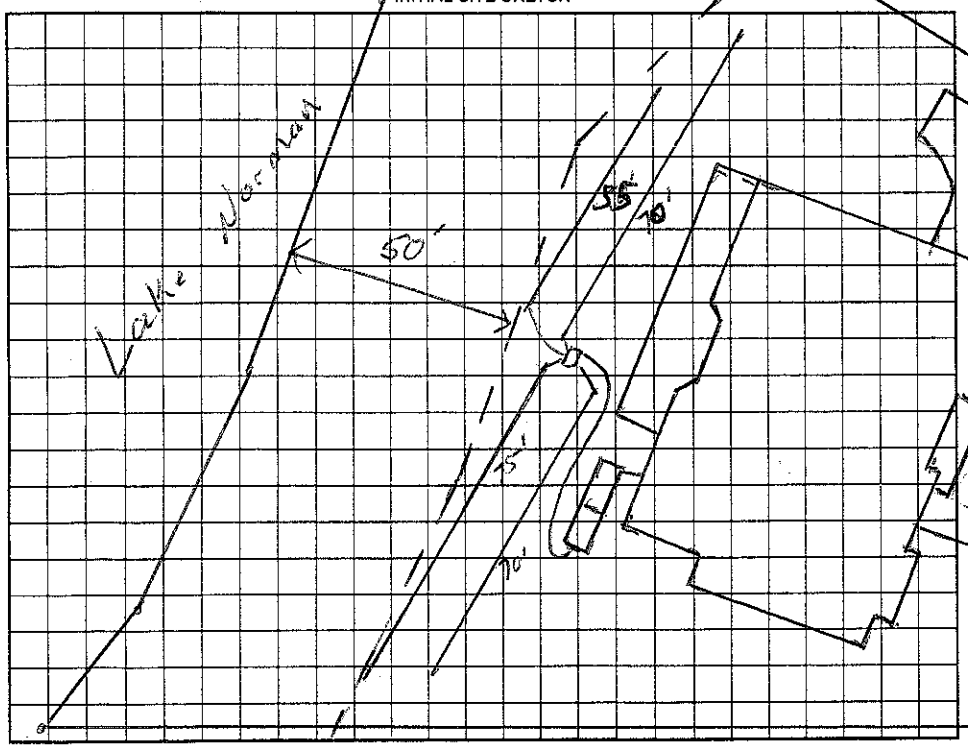

AS BUILT SKETCH

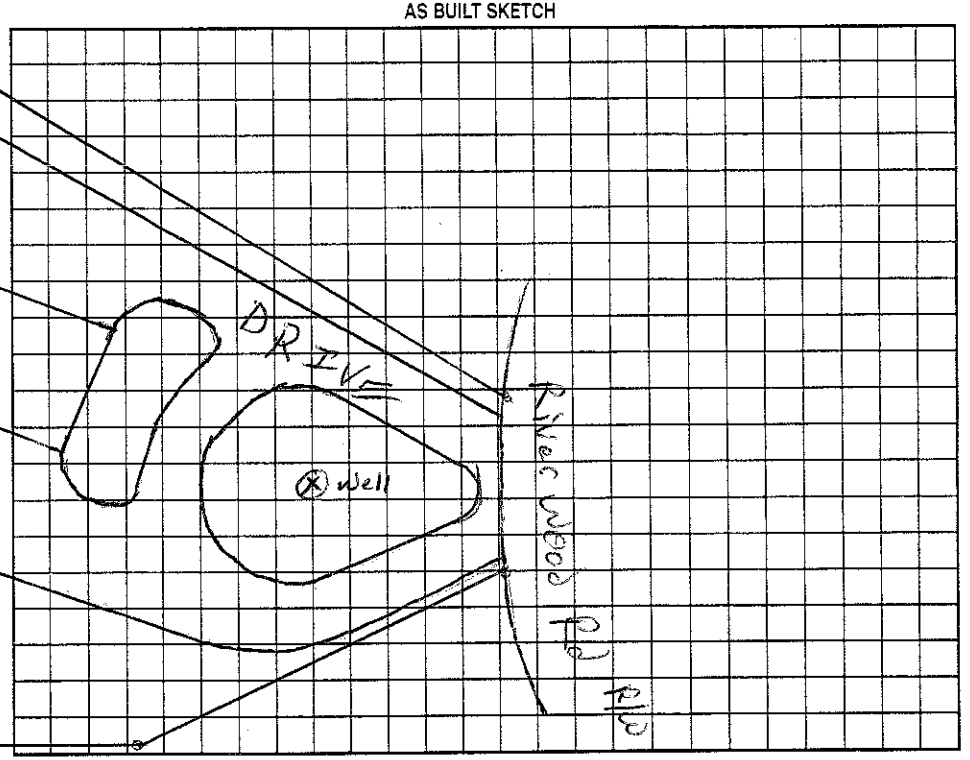

Permit can be suspended or revoked if any false information is supplied toward securing the permit/any unauthorized changes are made to the site/any unauthorized changes are made in the installation of the system. Improvement Permit with plat valid without expiration. Improvement Permit with site plan valid for sixty months. Authorization to Construct is valid for a period equal to that of Improvement Permit – not to exceed sixty months.

Signed: Barton Ward Mann date 6-14-04 Installed by: Hallmark Const

Improvement Permit by: RS date 6/10/04 Operation Permit by: RS date 9/17/04

Authorization to Construct by: RS date 6/10/04 Existing System Inspection by: date

HEALTH DEPT. COPY: WHITE OWNER COPY (FINAL): YELLOW OWNER COPY (INITIAL): PINK