IREDELL COUNTY HEALTH DEPARTMENT

Statesville Phone TR 3-7271 Mooresville Phone No. 664-5281

PERMIT TO INSTALL SEPTIC TANK

Permit No. 141 Permit Date 6-22 1973

Owner Joel W. Crabtree Address Huntersville N.C. R 3 Box 57

Installed By C & C Construction Address Kannapolis N.C.,


Location of Property Hwy 150 W. Past Rock Quarry T L on Rd 1211. Kept to L at forks of rd. Go Past gate at back of rock Quarry. 1st Drive on R. Next to Sells.

Tank		Capacity		Length of Lines		Fixtures	
Block	( )	1000	(✓)	225'	(✓)	No. of Baths	(1)
Precast	(✓)	1250	( )	250'	( )	Dishwasher	( )
		1500	( )	Other		Garbage Grdr.	( )
		Other				Other	

NOTIFY HEALTH DEPARTMENT AT LEAST EIGHT HOURS BEFORE TANK IS TO BE INSPECTED.

Final Inspection 6-21 1973 Approved (✓) Disapproved ( )

Remarks Lake No Well at time of inspection

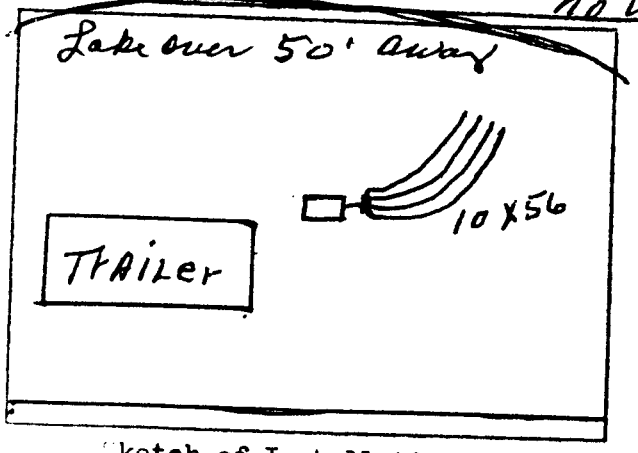

Sketch of Installation

Section 10 Lot 114
10 X 56 is the best layout Possible due to rock in Soil.

E. G. Stevenson
Sanitarian