IREDELL COUNTY HEALTH DEPARTMENT

(SEPTIC TANK) IMPROVEMENTS PERMIT AND CERTIFICATE OF COMPLETION
(Ground Absorption Sewage Disposal System -- G. S. Chapter 130-Article 13C)

OWNER OR CONTRACTOR William Spencer DATE 11-10-86 PERMIT NO. 592

PHONE: Business _____ Home _____

LOCATION 150 W TL 1211 (Paradise Peninsula) TL Green Bay - 1 1/4 mi to Rt at "Jordan" sign at end on left S. R. No. _____

SUBDIVISION NAME _____ LOT NO. _____ SECTION OR BLOCK NO. _____

House ( ) Mobile Home ( ) Business ( ) Other Replacing M.H. with House


No. Bedrooms 3 No. Bathrooms 2

Garbage Disposal Unit	Yes ( )	No (✓)	
Auto. Dishwasher	Yes (✓)	No ( )	
Auto. Wash. Machine	Yes (✓)	No ( )	
Site Suitable	Yes (✓)	No ( )	

Character & Porosity of Soil _____
Percolation Rate _____
Topography _____
Depth to Water Table _____
Rock or other impervious formations _____

Lot Area Existing

✓ Basement with Plumbing _____ Basement without Plumbing _____ No Basement

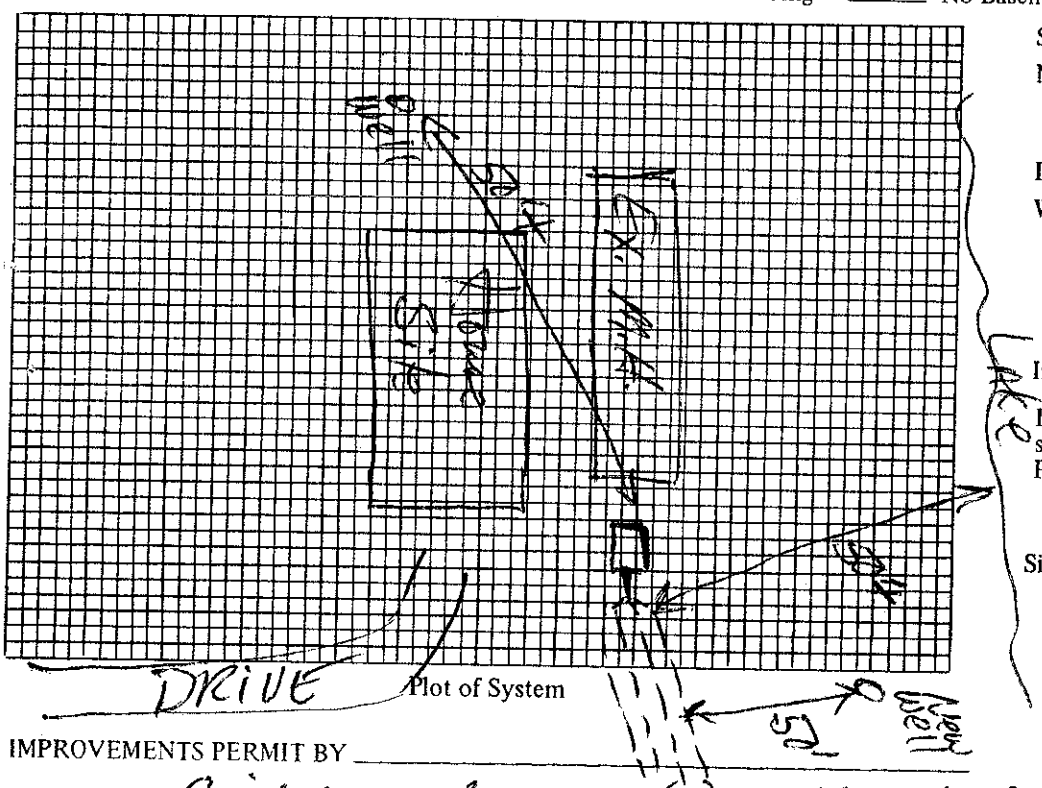

Plot of System

Size of Tank Existing Gals.
Nitrification Field:
No. of Lines Existing
Sq. Ft. _____ Linear Ft. _____
Depth of Stone in Lines _____
Water Supply: Individual ( )
Public ( )

Installed by _____

I understand and agree to install septic tank system as specified on this Improvements Permit.

Signed: _____

IMPROVEMENTS PERMIT BY _____

COMMENTS: Existing system working OK at time of inspection. M.H. to be moved off when house is completed.

CERTIFICATE OF COMPLETION BY _____ DATE _____

EXISTING SYSTEM CHECKED BY: J. K. Hanson, R.S. DATE 11-10-86

CONSTRUCTION MUST COMPLY WITH ALL OTHER APPLICABLE STATE AND LOCAL REGULATIONS.

Permit is VOID if any unauthorized changes are made in installation of system and/or if any false information is supplied in making Improvements Permit.

Health Dept. Copy: White Inspection Dept. Copy: Yellow Sanitarian's Copy: Pink Owner's Copy: Gold

IREDELL COUNTY HEALTH DEPARTMENT

Statesville Phone TR 3-7271 Mooresville Phone No. 664-5281

PERMIT TO INSTALL SEPTIC TANK

Permit No. 141 Permit Date 6-21 1973

Owner Joel W. Crabtree Address Huntersville N.C. R 3 Box 379

Installed By C & C Construction Address Kannapolis N.C.,


Location of Property Hwy 150 W. Past Rock Quarry Tk On Rd 1211. Keep to L at forks of rd. Go Past gate at back of rock Quarry. 1st Drive on R. Next to Sewer.

Tank		Capacity		Length of Lines		Fixtures	
Block	( )	1000	(✓)	225'	(✓)	No. of Baths	(1)
Precast	(✓)	1250	( )	250'	( )	Dishwasher	( )
		1500	( )	Other		Garbage Grdr.	( )
		Other				Other	

NOTIFY HEALTH DEPARTMENT AT LEAST EIGHT HOURS BEFORE TANK IS TO BE INSPECTED.

Final Inspection 6-21 1973 Approved (✓) Disapproved ( )

Remarks Lake No well at time of inspection

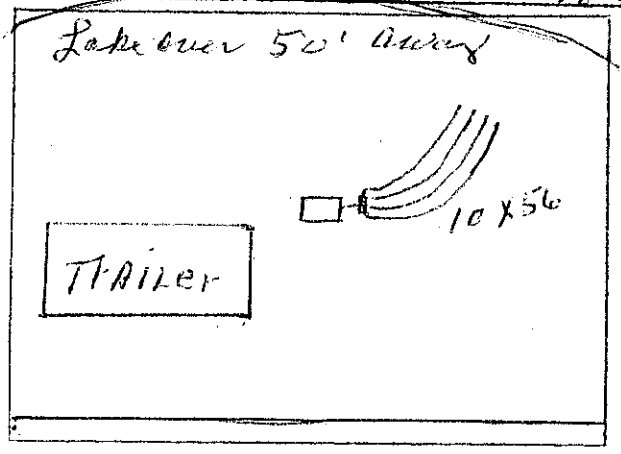

Sketch of Installation

Section 10 Lot 114

10 X 56 is the best layout Possible due to rock in Soil.

E. G. Stutzman

Sanitarian