IREDELL COUNTY HEALTH DEPARTMENT

STATESVILLE 704-878-5305 MOORESVILLE 704-664-5281

IMPROVEMENT PERMIT / AUTHORIZATION TO CONSTRUCT / OPERATION PERMIT / EXISTING SYSTEM INSPECTION

4627960789 1.30

PERMIT# Repair PIN#

OWNER OR CONTRACTOR Carl + Carolyn Hist PHONE: Business Home (704) 799-1178 DATE 3/12/03

ADDRESS 119 Norcross Ln. Mooresville NC 28117

LOCATION 150W, TL Quartcove, TR Ridgetop, TR Greenbay, TL Norcross on Lt.

SUBDIVISION CL+T BLOCK / SECTION 10 LOT 114 LOT AREA 1.22 AC SITE CLASS. PS DESIGN FLOW 360 L.T.A.R. —

Septic Tank: Existing Gallons; STB Date

Pump Tank: Gallons; PT Date

Pump Make: Model Serial No.

Nitrification Field: No Fields Square Feet 600 Linear Feet

No Lines Trench Width 12"x50' Max Trench Bottom Depth 36" Gravel Depth —

☐ New System ☒ Repair System Type: I, II, (III), IV, V, VI

System Description:

Repair System Description: 25% Reduction Bed

Maintenance Agreement Required: ☐ Yes ☐ No

☒ House/Mod. Home No. Bedrooms 3

☐ Mobile Home No. Bathrooms

☐ Business No. Employees

☐ Other

☐ Slab ☐ Crawl Space ☐ Basement w/plumbing ☐ Basement wo/plumbing


Water Supply: ☒ Individual ☐ Public ☐ Community

Comments:/Conditions:


NOT to Scale

Comments:/Conditions:

INITIAL SITE SKETCH

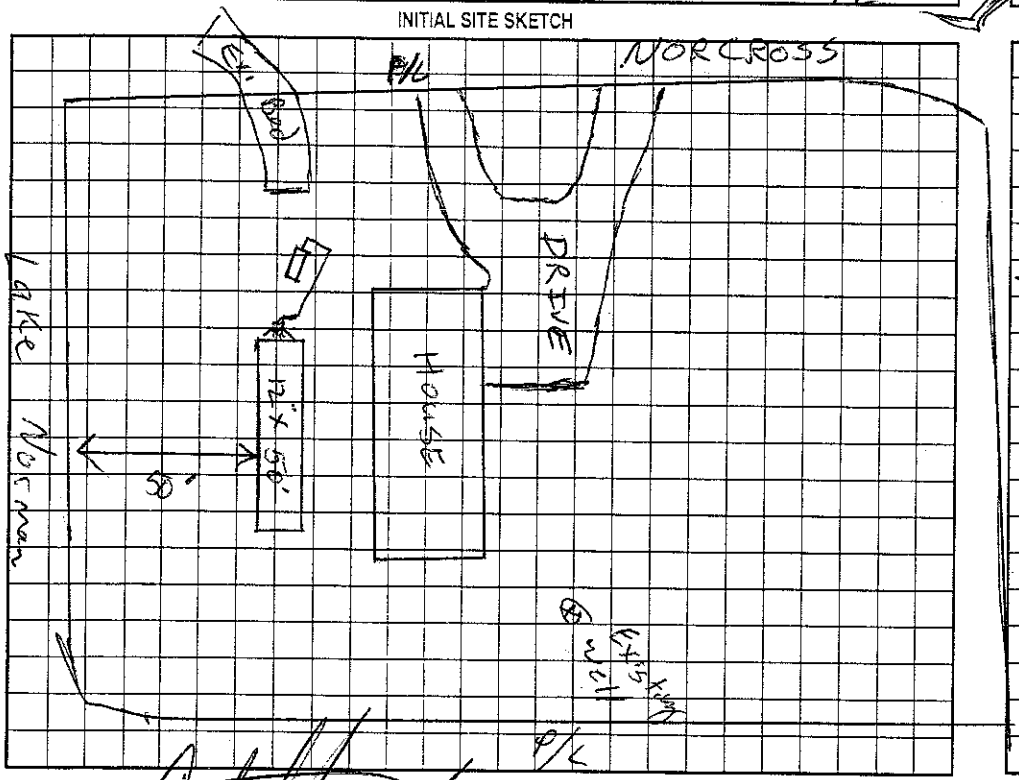

AS BUILT SKETCH

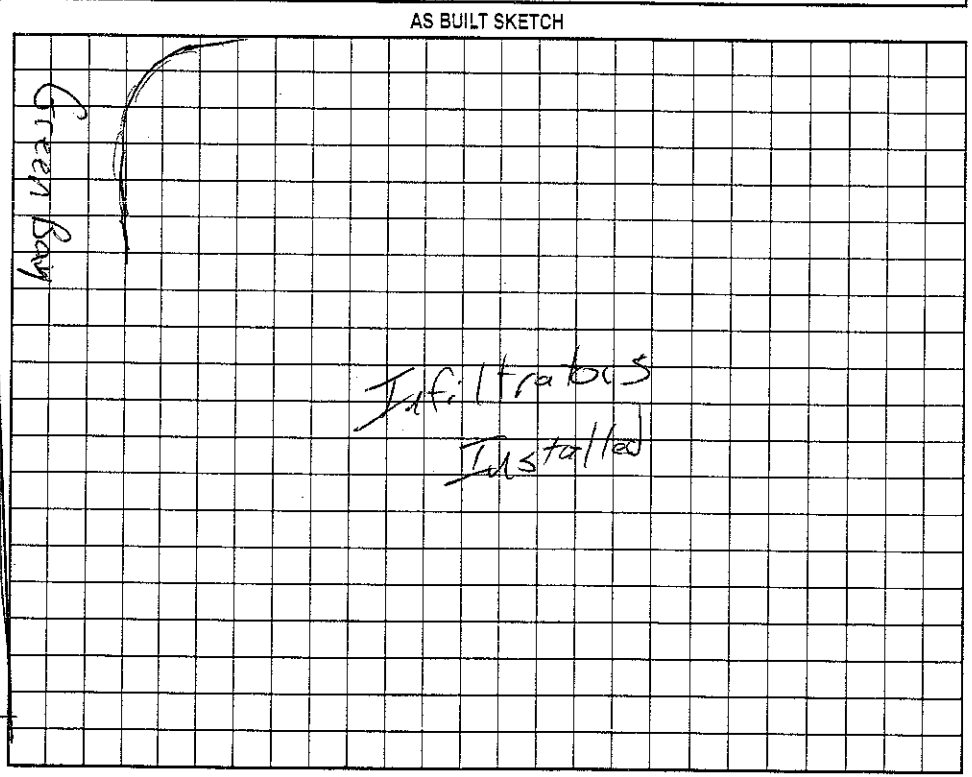

Permit can be suspended or revoked if any false information is supplied toward securing the permit/any unauthorized changes are made to the site/any unauthorized changes are made in the installation of the system. Improvement Permit with plat valid without expiration. Improvement Permit with site plan valid for sixty months. Authorization to Construct is valid for a period equal to that of Improvement Permit – not to exceed sixty months.

Signed: date 3/12/03 Installed by: C.A. Sloop Dirt Art.

Improvement Permit by: RS date 3/12/03 Operation Permit by: RS date 3/26/03

Authorization to Construct by: RS date 3/12/03 Existing System Inspection by: date

HEALTH DEPT. COPY: WHITE OWNER COPY (FINAL): YELLOW OWNER COPY (INITIAL): PINK