IREDELL COUNTY HEALTH DEPARTMENT

Statesville Office (704) 878-5305 Mooresville Office (704) 660-3625

PERMIT # Old 37741 / New 144755

IMPROVEMENT PERMIT / AUTHORIZATION TO CONSTRUCT / OPERATION PERMIT / EXISTING SYSTEM

PIN # 4679630780

APPLICANT: Kenny Habul Greenbay Electronics APPLICANT ADDRESS: 28117

SITE ADDRESS: 446 Green Bay Rd Mooresville, NC PHONE: ALT. PHONE:

SITE DIRECTIONS:


SUBDIVISION: Cleat SECTION: 10 LOT # 107 LOT AREA: ~.97AC DESIGN FLOW: 480 L.T.A.R.: .3

Septic Tank ____ (gal)	STB ____	Date ____	☒ New System ☐ Repair ☐ Expansion System Type: I II III IV V VI	☒ Residence	No. Bedrooms ____	Water Supply
Pump Tank ____ (gal)	PT ____	Date ____	System Description: Pump-LP-Panel Block	☐ Business	No. Persons ____	☒ Private
Pump Make ____	Model ____	Serial # ____	Repair System Description: Same	☐ Other	No. Employees ____	☐ Public
# Nitrification Fields 1	# Lines 4	Linear Ft: 260'	Maintenance Agreement Required: ☒ YES ☐ NO	☐ Slab	☐ Crawl Space	☐ Community
Trench Width 24"	Max. Trench Bottom Depth 36"	Gravel Depth N/A	☐ GRAVITY ☒ PRESSURE	☒ Basement w/plumbing		☐ Basement w/o plumbing


Comments / Conditions: Tanks checked by WS 10/1/08

10/7/2011 Checked lines & pressure

INITIAL SITE SKETCH

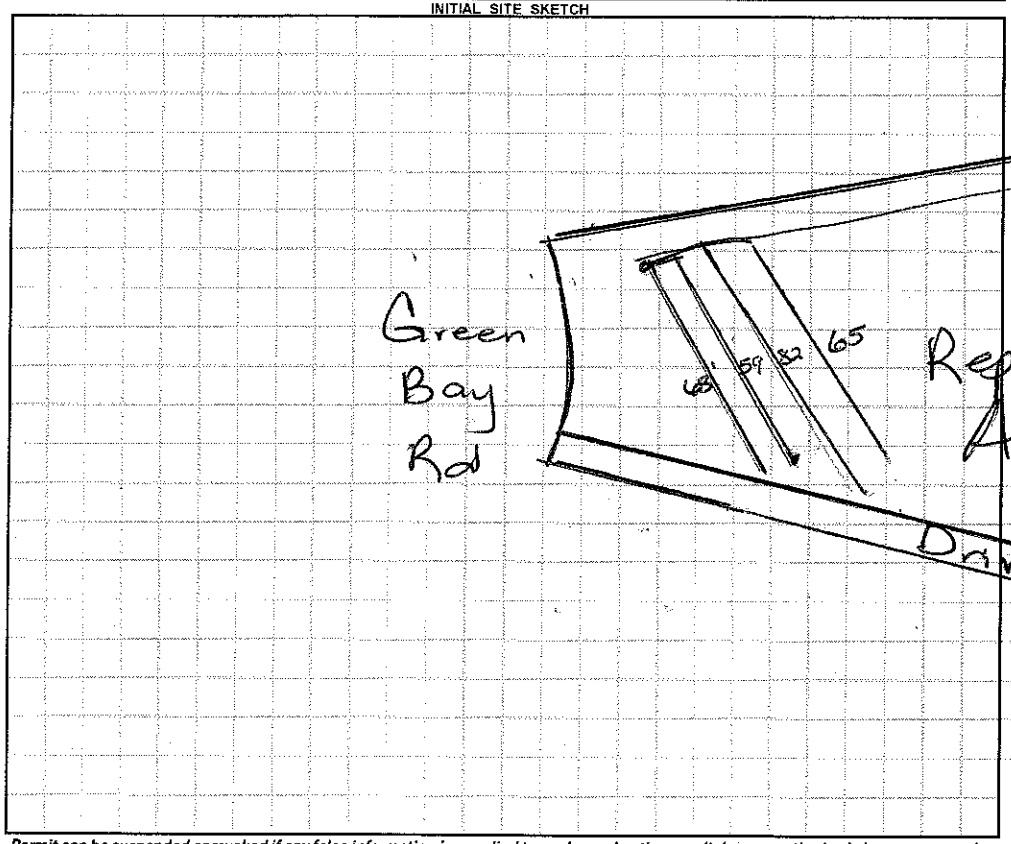

AS BUILT SKETCH

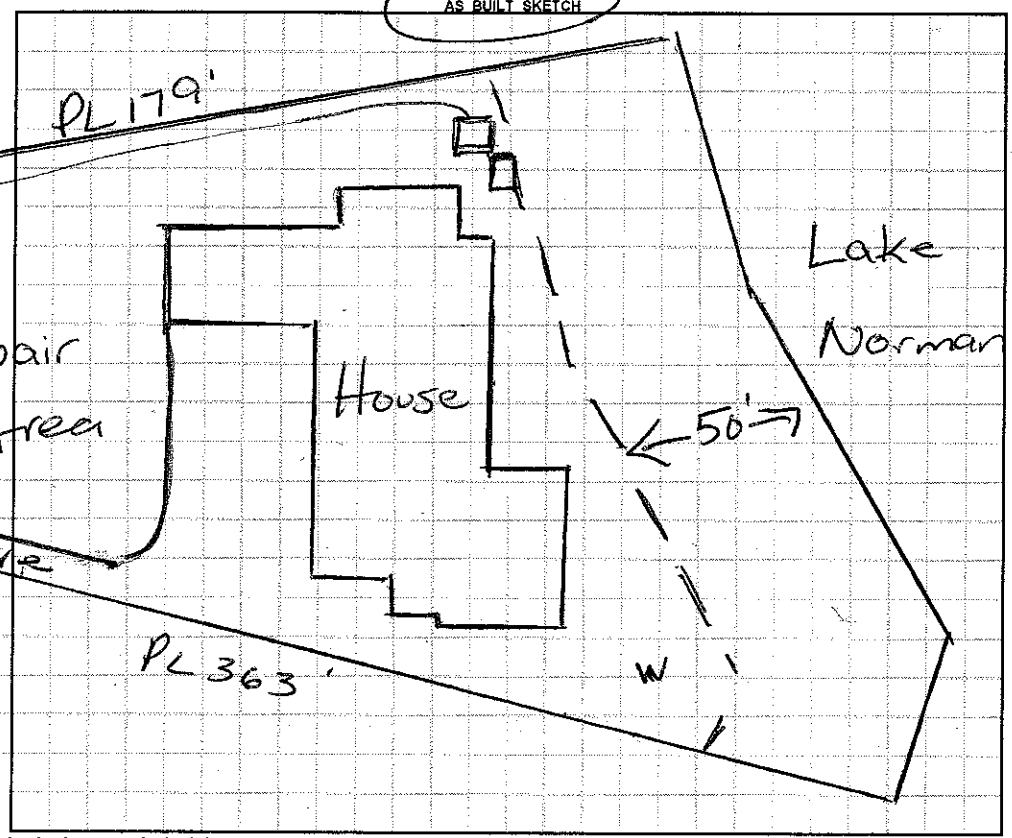

Permit can be suspended or revoked if any false information is supplied toward securing the permit / any unauthorized changes are made to the site / any unauthorized changes are made in the installation of the system. **CONTACT A LOCATOR SERVICE PRIOR TO ANY EXCAVATION**

☐ **IMPROVEMENT PERMIT** ***with plat*** *valid without expiration.* ☐ **IMPROVEMENT PERMIT** ***with site plan*** *valid for 60 mos.* ☐ **AUTHORIZATION TO CONSTRUCT** *valid for period equal to IMPROVEMENT PERMIT--not to exceed 60 mo.*

Owner / Applicant Signature: Date: Installed by: Rowan Septic

IMPROVEMENT PERMIT by: Date: OPERATION PERMIT by: Manuel H. Dotson RS Date: 9/28/13

AUTHORIZATION TO CONSTRUCT by: Date: Existing System Inspected by: Date:

Health Dept. Copy - WHITE Applicant (Final Approval) - YELLOW Applicant (Conditional Approval) - PINK

IREDELL COUNTY HEALTH DEPARTMENT

STATESVILLE 704-878-5305 MOORESVILLE 704-664-5281

3445 GRANDELL

IMPROVEMENT PERMIT / AUTHORIZATION TO CONSTRUCT / OPERATION PERMIT / EXISTING SYSTEM INSPECTION

PERMIT# 137741 PIN# 4627 96 3078 DATE 9/28/07

OWNER OR APPLICANT Kenny Hulse PHONE: Business 416-723-2375 Home 704-898-7775

ADDRESS PO Box 3033 Mooresville, NC. 28117

LOCATION 446 Green Bay Rd. on (L)

SUBDIVISION C.L.+T. BLOCK / SECTION 10 LOT 107 LOT AREA ~.97Ac SITE CLASS. PS DESIGN FLOW 480 L.T.A.R. .3

Septic Tank: 1000 Gallons: STB 825 Date 7/29/08

Pump Tank: 1000 Gallons: PT 302 Date 8/1/08

Pump Make: Hydroma Model SHEF-45M Serial No.

Nitrification Field: No Fields 1 Square Feet 807 Linear Feet 270

No Lines 5 Trench Width 2-3' Max Trench Bottom Depth 3'

☒ New System ☐ Repair ☐ Expansion System Type: I II III IV V VI

System Description: Pressure - 16" PABPS

Repair System Description: Same Type

Maintenance Agreement Required: ☒ Yes ☐ No

☒ House/Mod. Home ☐ Mobile Home ☐ Business ☐ Other

No. Bedrooms 4 No. Persons ___ No. Employees ___

Water Supply: ☒ Individual ☐ Public ☐ Community NEW


Gravel Depth No ☐ Gravity ☒ Pressure ☐ Slab ☐ Crawl Space ☒ Basement w/plumbing ☐ Basement wo/plumbing

Comments:/Conditions: Well 1 needs to be properly Abandoned by Well Driller, Well 2 needs tagged in the area shown Tanks Checked 10/1/08 WS


Comments:/Conditions: Need In line filter in PT Checked lines 10/7/2011 & pressure

(1" = 50')

INITIAL SITE SKETCH

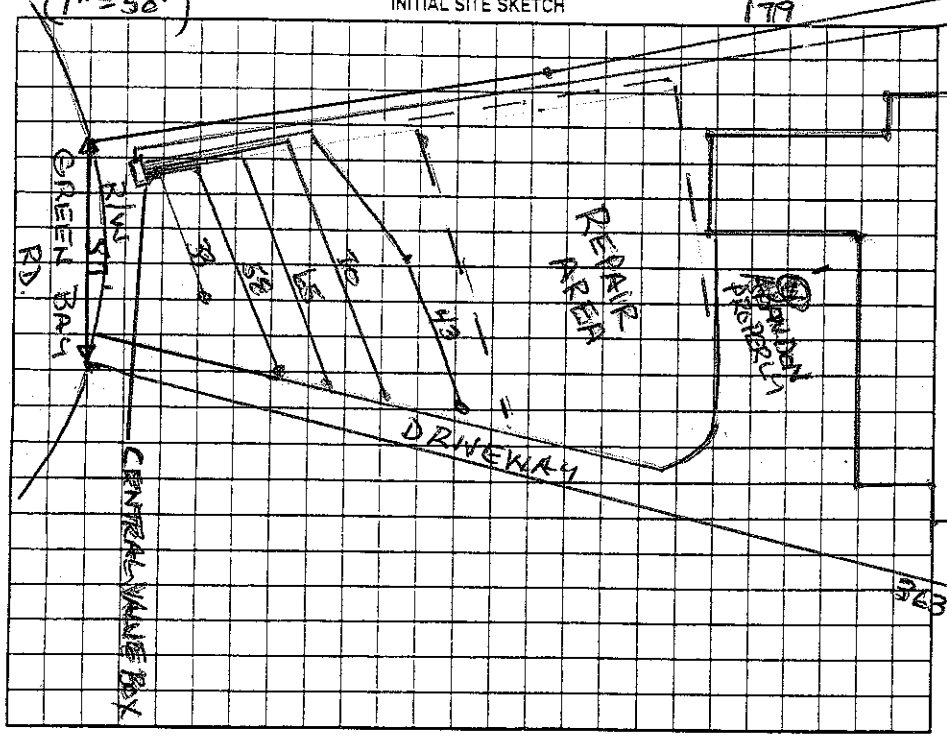

AS BUILT SKETCH

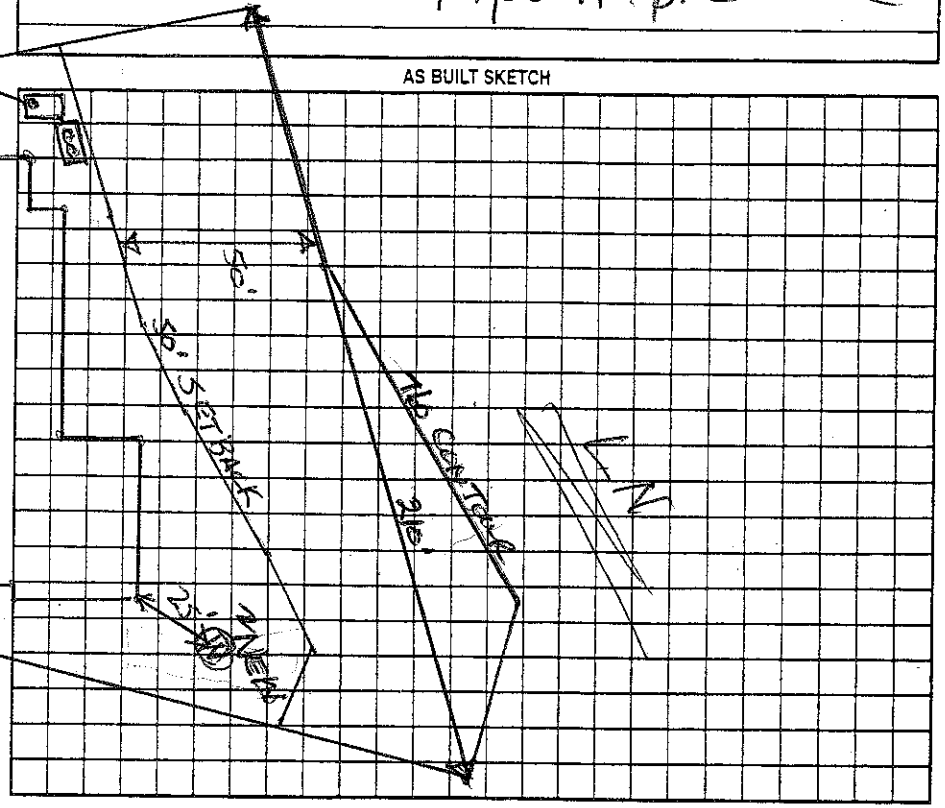

Permit can be suspended or revoked if any false information is supplied toward securing the permit/any unauthorized changes are made to the site/any unauthorized changes are made in the installation of the system. Improvement Permit with plat valid without expiration ☐ Improvement Permit with site plan valid for sixty months ☒ Authorization to Construct is valid for a period equal to that of Improvement Permit – not to exceed sixty months.

Signed: ☒ date 10/25/07 Installed by: Rowan Septic Tank

Improvement Permit by: Wesley Sparks R.S. date 9/28/07 Operation Permit by: Maria Dobson RS date 4/28/13

Authorization to Construct by: Wesley Sparks R.S. date 10/17/07 Existing System Inspection by: ___ date ___

HEALTH DEPT. COPY: WHITE OWNER COPY (FINAL): YELLOW OWNER COPY (INITIAL): PINK