IREDELL COUNTY HEALTH DEPARTMENT

STATESVILLE 704-878-5305 MOORESVILLE 704-664-5281

200 130

IMPROVEMENT PERMIT / AUTHORIZATION TO CONSTRUCT / OPERATION PERMIT / EXISTING SYSTEM INSPECTION

PERMIT# 113578 PIN# ~~4627-88-5496.033~~ 4627965416 DATE October 20, 2003

OWNER OR CONTRACTOR Greenbay Forest LLC / Ray Taylor PHONE: Business Home

ADDRESS P.O. Box 3608, Mooresville, N.C. 28117

LOCATION 150 West TL Paradise Peninsula TL Greenbay on left

SUBDIVISION Greenbay Forest BLOCK / SECTION LOT 33 LOT AREA 1.67 Ac SITE CLASS. PS DESIGN FLOW 480 gpd L.T.A.R. .3

Septic Tank: 1000 Gallons; STB 794 Date 4/19/05

Pump Tank: 1000 Gallons; PT 27 Date 4/21/05

Pump Make: Liberty Model 283 Serial No.

Nitrification Field: No Fields 1 Square Feet 1200 Linear Feet 400

No Lines 5 @ 80' Trench Width 36" Max Trench Bottom Depth 36"

☑ New System ☐ Repair System Type: I, II, III, IV, V, VI

System Description: pm - 25% Reduction

Repair System Description: LPP/AS

Maintenance Agreement Required: ☐ Yes ☑ No initially

Gravel Depth NA

☑ House/Mod. Home ☐ Mobile Home ☐ Business ☐ Other

No. Bedrooms 4 No. Bathrooms 4 No. Employees


Water Supply: ☐ Individual ☐ Public ☐ Community

☐ Slab ☑ Crawl Space ☐ Basement w/plumbing ☐ Basement wo/plumbing


Comments:/Conditions:

Comments:/Conditions:

INITIAL SITE SKETCH 1"=50'

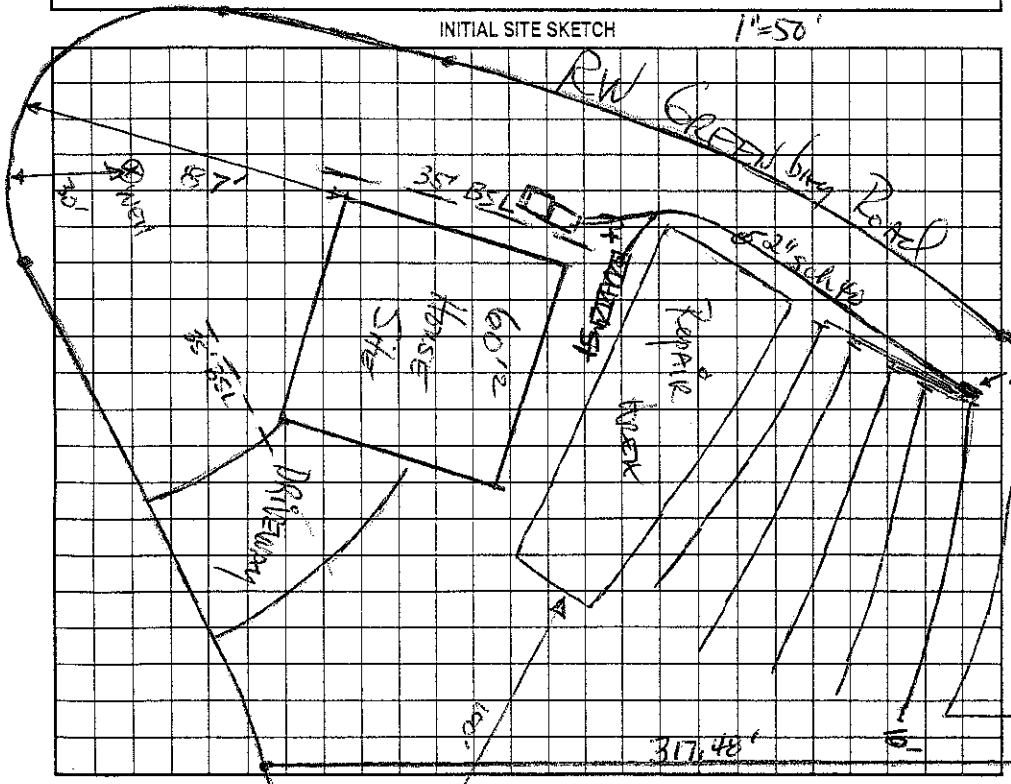

AS BUILT SKETCH

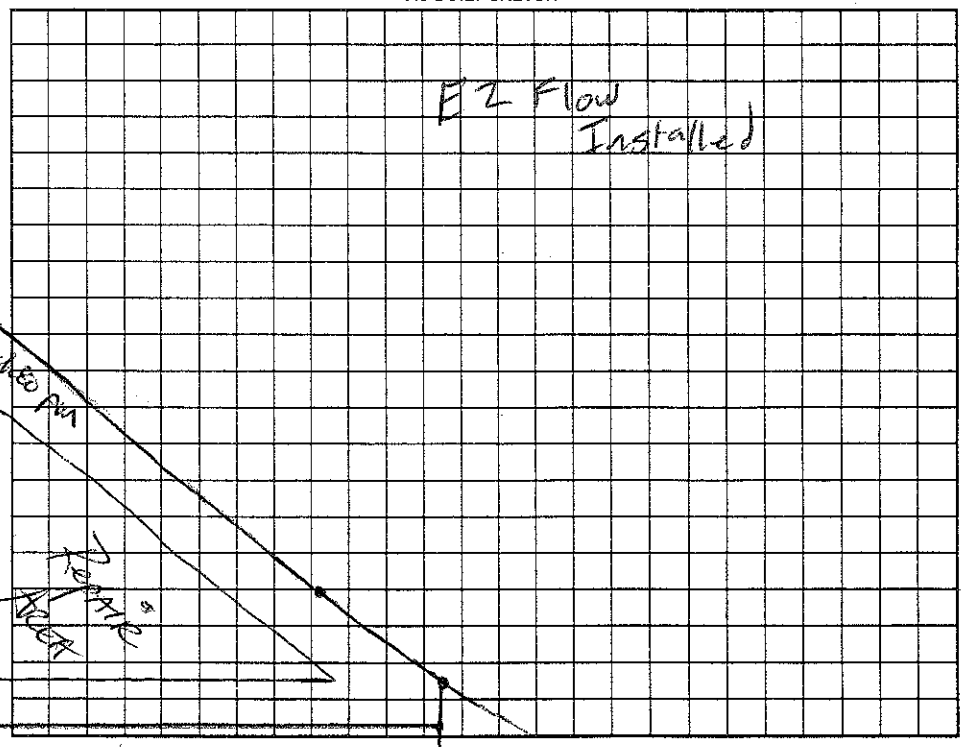

Permit can be suspended or revoked if any false information is supplied toward securing the permit/any unauthorized changes are made to the site/any unauthorized changes are made in the installation of the system. Improvement Permit with plat valid without expiration. Improvement Permit with site plan valid for sixty months. Authorization to Construct is valid for a period equal to that of Improvement Permit – not to exceed sixty months.

Signed: date 10-30-03 Installed by: Howard's backhoe

Improvement Permit by: RS date 10-20-03 Operation Permit by: RS date 7/14/05

Authorization to Construct by: RS date 3/25/05 Existing System Inspection by: date

HEALTH DEPT. COPY: WHITE OWNER COPY (FINAL): YELLOW OWNER COPY (INITIAL): PINK