IREDELL COUNTY HEALTH DEPARTMENT

STATESVILLE 704-878-5305 MOORESVILLE 704-664-5281

IMPROVEMENT PERMIT / AUTHORIZATION TO CONSTRUCT / OPERATION PERMIT / EXISTING SYSTEM INSPECTION

PERMIT # 157329 PIN # 4627966115 DATE 7/14/09

OWNER or APPLICANT Charles Schmidt PHONE: Business 704.668.3031 Home:

OWNER or APPLICANT ADDRESS 450 Greenbay Dr mooresville, NC 28117

LOCATION / DIRECTIONS 150 W, TL Quiet Cove, TR Ridge Top, TR Greenbay, on lft

SUBDIVISION C I & T BLOCK / SECTION 10 LOT # 105 LOT AREA DESIGN FLOW 360 gpd L.T.A.R.

Septic Tank existing tank Gallons: STB Date

Pump Tank Gallons: P T Date

Pump Make Model Serial #

Nitrification Field No Fields 1 No Lines 2 Linear Feet 200

Trench Width 24" Max. Trench Bottom Depth 36" Gravel Depth

☐ New System ☐ Repair ☐ Expansion System Type I II III IV V VI

System Description: existing system panel

Repair System Description: exempt

Maintenance Agreement Required ☐ YES ☒ NO

☒ GRAVITY ☐ PRESSURE

☒ Residence No. Bedrooms 3

☐ Business No. Persons

☐ Other No. Employees

☐ Slab ☐ Crawl Space

☐ Basement w/plumbing ☐ Basement w/o plumbing


Water Supply ☐ Private ☐ Public ☒ Community

Comments / Conditions


* maintain all setbacks
* Existing System inspection only

Comments / Conditions

INITIAL SITE SKETCH

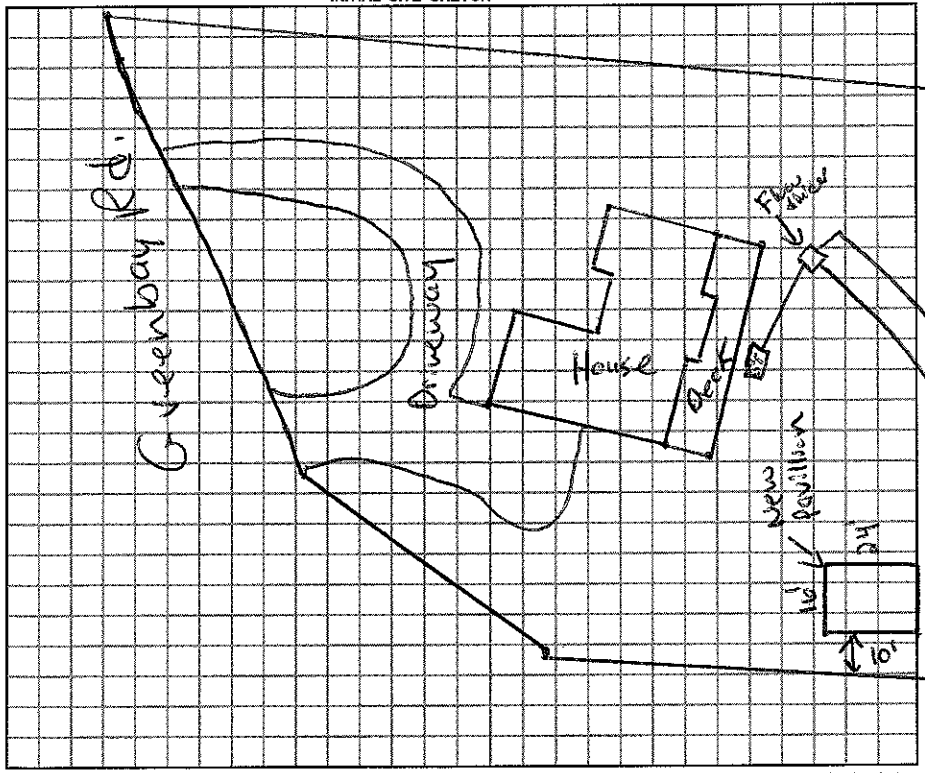

AS BUILT SKETCH

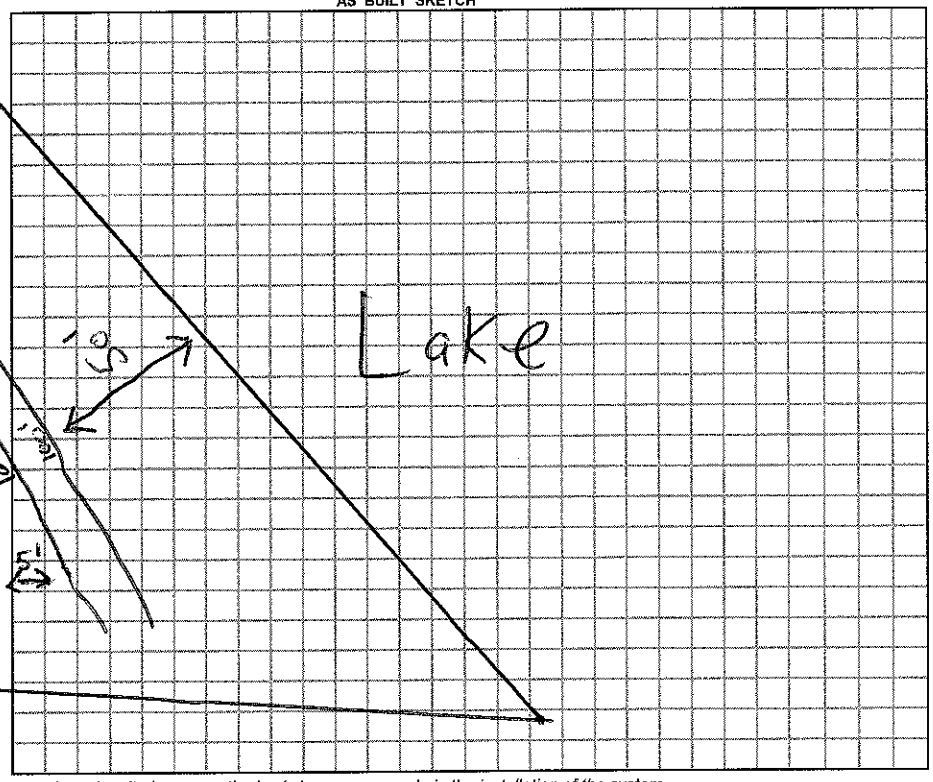

Permit can be suspended or revoked if any false information is supplied toward securing the permit / any unauthorized changes are made to the site / any unauthorized changes are made in the installation of the system.

☐ *IMPROVEMENT PERMIT w / plat valid without expiration* ☐ *IMPROVEMENT PERMIT w / site plan valid for 60 mos.* ☐ *AUTHORIZATION TO CONSTRUCT valid for period equal to IMPROVEMENT PERMIT-not to exceed 60 mo.*

Owner / Applicant Signature: Date 8/3/09

Improvement Permit by: Date

Authorzation to Construct by: Date

Installed by:

Operation Permit by: Date:

Existing System Inspected by: Date: 7/14/09

YOU SHOULD CONTACT A LOCATOR SERVICE PRIOR TO ANY EXCAVATION.

WHITE COPY Environmental Health YELLOW COPY (Final) Owner / Applicant PINK COPY (Initial) Owner / Applicant