IREDELL COUNTY HEALTH DEPARTMENT

STATESVILLE 704-878-5305 MOORESVILLE 704-664-5281

IMPROVEMENT PERMIT / AUTHORIZATION TO CONSTRUCT / OPERATION PERMIT / EXISTING SYSTEM INSPECTION

PERMIT# 113520 PIN# 4622-88-5496.035 4627-96-7620 DATE Oct. 22, 03

OWNER OR CONTRACTOR Greenbay Forest LLC / RAY SHORT PHONE: Business Home

ADDRESS P.O. Box 3608, Mooresville, N.C. 28117

LOCATION 150 West TL Paradise Peninsula TL Greenbay on left past old Quarry site

SUBDIVISION Greenbay Forest BLOCK / SECTION LOT 35 LOT AREA .75Ac SITE CLASS PS DESIGN FLOW 480gpd L.T.A.R. .03

Septic Tank: 1000 Gallons; STB 794 Date 7/15/04

Pump Tank: 1000 Gallons; PT 27 Date 7/24/04

Pump Make: Gould's Model 1/2 Horse Serial No.

Nitrification Field: No Fields 1 Square Feet 1200 Linear Feet 400

No Lines 5 @ 80' Trench Width 36" Max Trench Bottom Depth 36" Gravel Depth NR

☑ New System ☐ Repair System Type: I, II, III, IV, V, VI

System Description: PM - 25% Reduction

Repair System Description: Stone

Maintenance Agreement Required: ☐ Yes ☑ No

☑ House/Mod. Home No. Bedrooms 4

☐ Mobile Home No. Bathrooms 4

☐ Business No. Employees

☐ Other

☐ Slab ☑ Crawl Space ☐ Basement w/plumbing ☐ Basement wo/plumbing


Water Supply: ☑ Individual ☐ Public ☐ Community

Comments:/Conditions:


Comments:/Conditions:

INITIAL SITE SKETCH

1"=50'

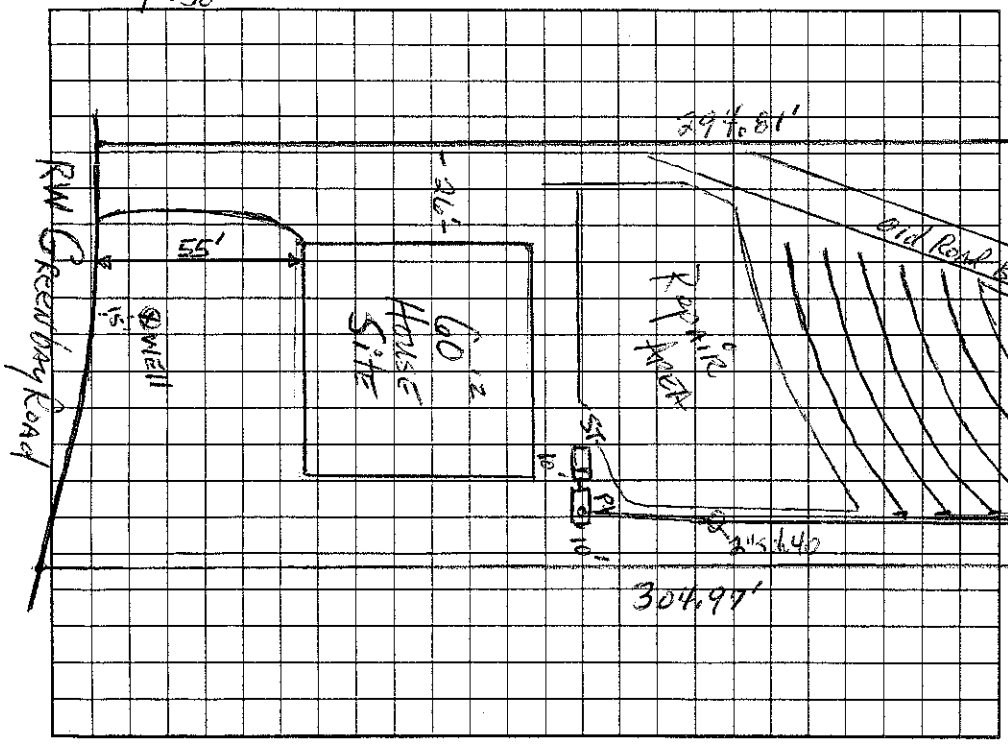

AS BUILT SKETCH

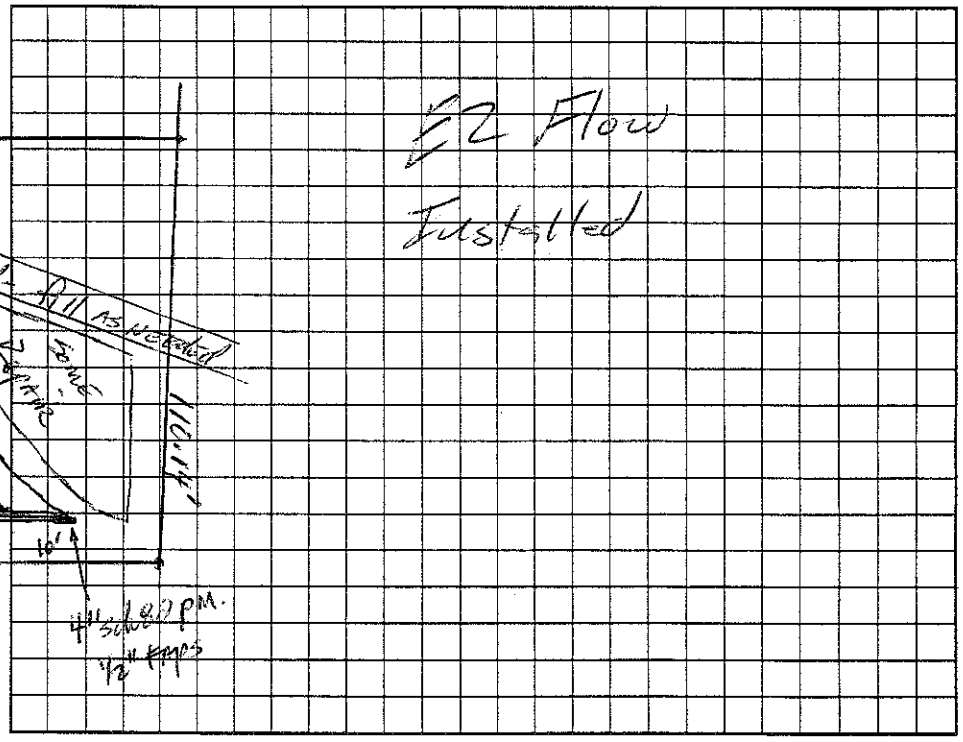

Permit can be suspended or revoked if any false information is supplied toward securing the permit/any unauthorized changes are made to the site/any unauthorized changes are made in the installation of the system. Improvement Permit with plat valid without expiration. Improvement Permit with site plan valid for sixty months. Authorization to Construct is valid for a period equal to that of Improvement Permit -- not to exceed sixty months.

Signed: date 10-3-03 Installed by: Howard's Backhoe

Improvement Permit by: RS date 10-22-03 Operation Permit by: RS date 12/3/04

Authorization to Construct by: RS date 6/9/04 Existing System Inspection by: date

HEALTH DEPT. COPY: WHITE OWNER COPY (FINAL): YELLOW OWNER COPY (INITIAL): PINK