IREDELL COUNTY HEALTH DEPARTMENT

STATESVILLE 704-878-5305 8100-Fair MOORESVILLE 704-664-5281

IMPROVEMENT PERMIT / AUTHORIZATION TO CONSTRUCT / OPERATION PERMIT / EXISTING SYSTEM INSPECTION

PERMIT# 113516 PIN# ~~4627885496.032~~ 4627-96-7812 DATE 9-21-04

OWNER OR CONTRACTOR Ray Short PHONE: Business 202-5568 Home

ADDRESS P.O. Box J 3792 Mooresville, NC 28117

LOCATION Hwy 150 West TL Paradise Peninsula TL Greenbay on left

SUBDIVISION Greenbay Forest BLOCK / SECTION LOT 32 LOT AREA 1.05 SITE CLASS. V/B DESIGN FLOW 480gpd L.T.A.R. .3

Septic Tank: 1000 Gallons; STB 317 Date 8/27/04
Pump Tank: Gallons; PT Date
Pump Make: Model Serial No.
Nitrification Field: No Fields 1 Square Feet 1200' Linear Feet 400'
No Lines 5@80' Trench Width 36" Max Trench Bottom Depth 36" Gravel Depth N/A

☒ New System ☐ Repair System Type: I, II, III, IV, V, VI
System Description: Gravity - 25% Reduction
Repair System Description: Same
Maintenance Agreement Required: ☐ Yes ☐ No


☒ House/Mod. Home No. Bedrooms 4
☐ Mobile Home No. Bathrooms 3
☐ Business No. Employees
☐ Other
☐ Slab ☒ Crawl Space ☐ Basement w/plumbing ☐ Basement wo/plumbing

Water Supply: ☒ Individual ☐ Public ☐ Community


Comments:/Conditions: Keep Septic System at least 10' From PL & 15' From pool.

Comments:/Conditions: EZ Lay

INITIAL SITE SKETCH Scale 1:50

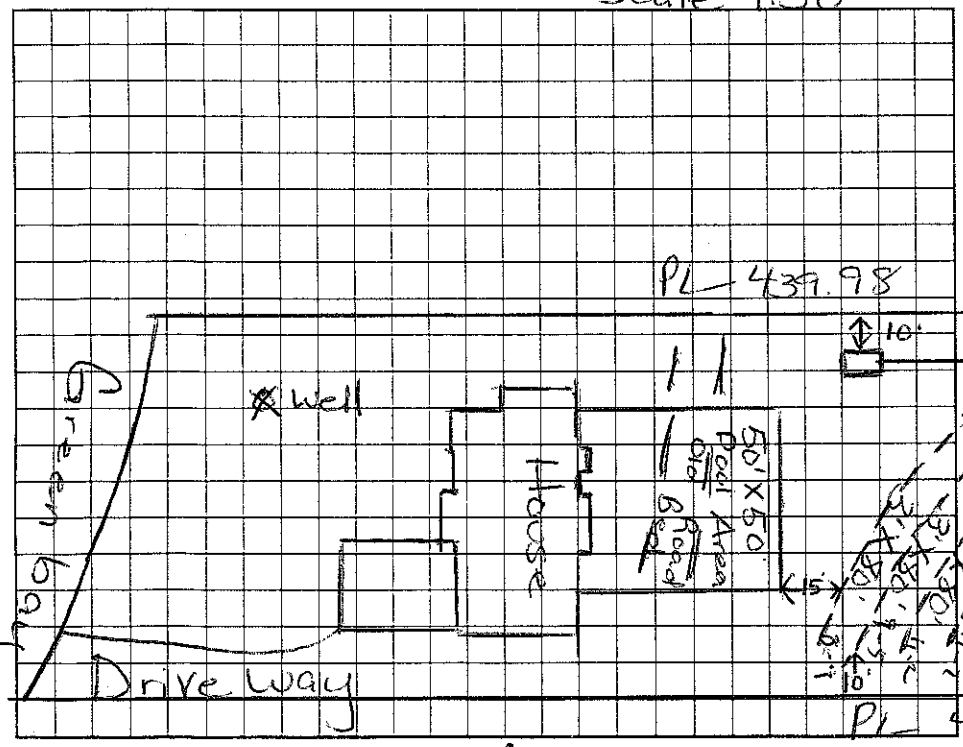

AS BUILT SKETCH

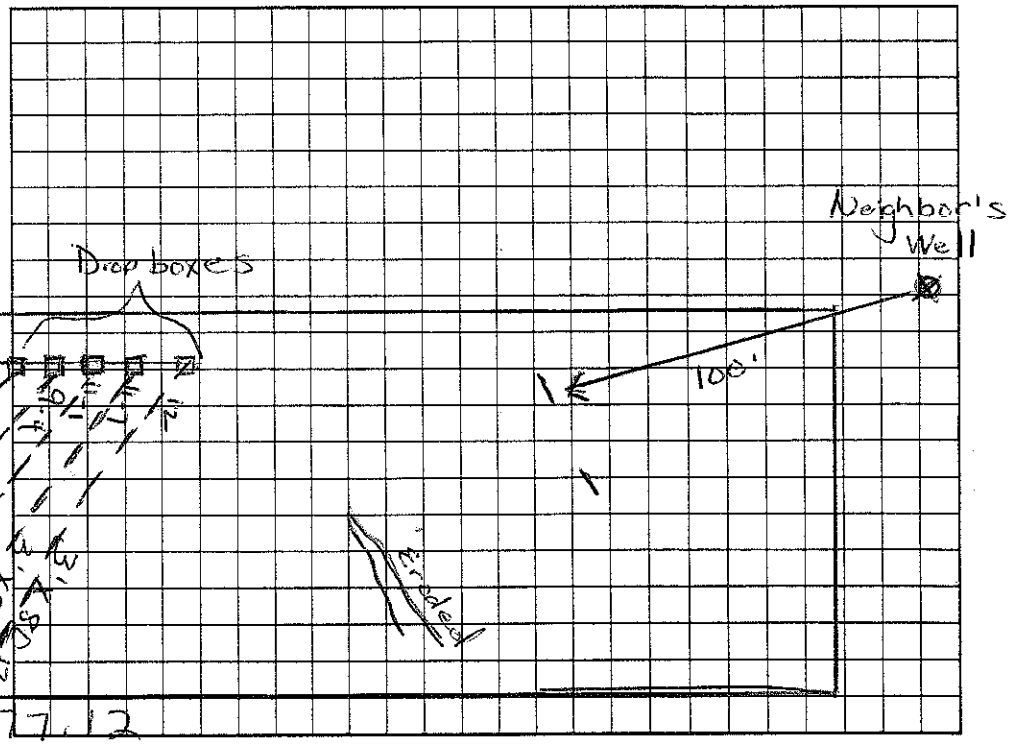

Permit can be suspended or revoked if any false information is supplied toward securing the permit/any unauthorized changes are made to the site/any unauthorized changes are made in the installation of the system. Improvement Permit with plat valid without expiration. Improvement Permit with site plan valid for sixty months. Authorization to Construct is valid for a period equal to that of Improvement Permit – not to exceed sixty months.

Signed: [signature] date 9-23-04 Installed by: Howards Backhoe

Improvement Permit by: [signature] RS date 9/22/04 Operation Permit by: Wesley Sparks RS. date 10/1/04

Authorization to Construct by: [signature] RS date 9/22/04 Existing System Inspection by: date

HEALTH DEPT. COPY: WHITE OWNER COPY (FINAL): YELLOW OWNER COPY (INITIAL): PINK